

IMPERVIOUS SURFACES

HOUSE =	1368 S.F.
COV. PATIO =	213 S.F.
SHED =	77 S.F.
SHED =	172 S.F.
BRICK PATIO =	2691 S.F.
POOL =	808 S.F.
TOTAL =	5329 S.F.

P.B. 91-136


LEGEND:

- IRON FOUND
- ⊗ IRON SET
- △ CALC. CORNER
- CONC. MCNU.

RATIO OF CLOSURE 1:10,000+

NOTES:

1. NO FEMA - DELINEATED 100 YEAR FLOOD ON PROPERTY.
2. NO RCD ON PROPERTY.

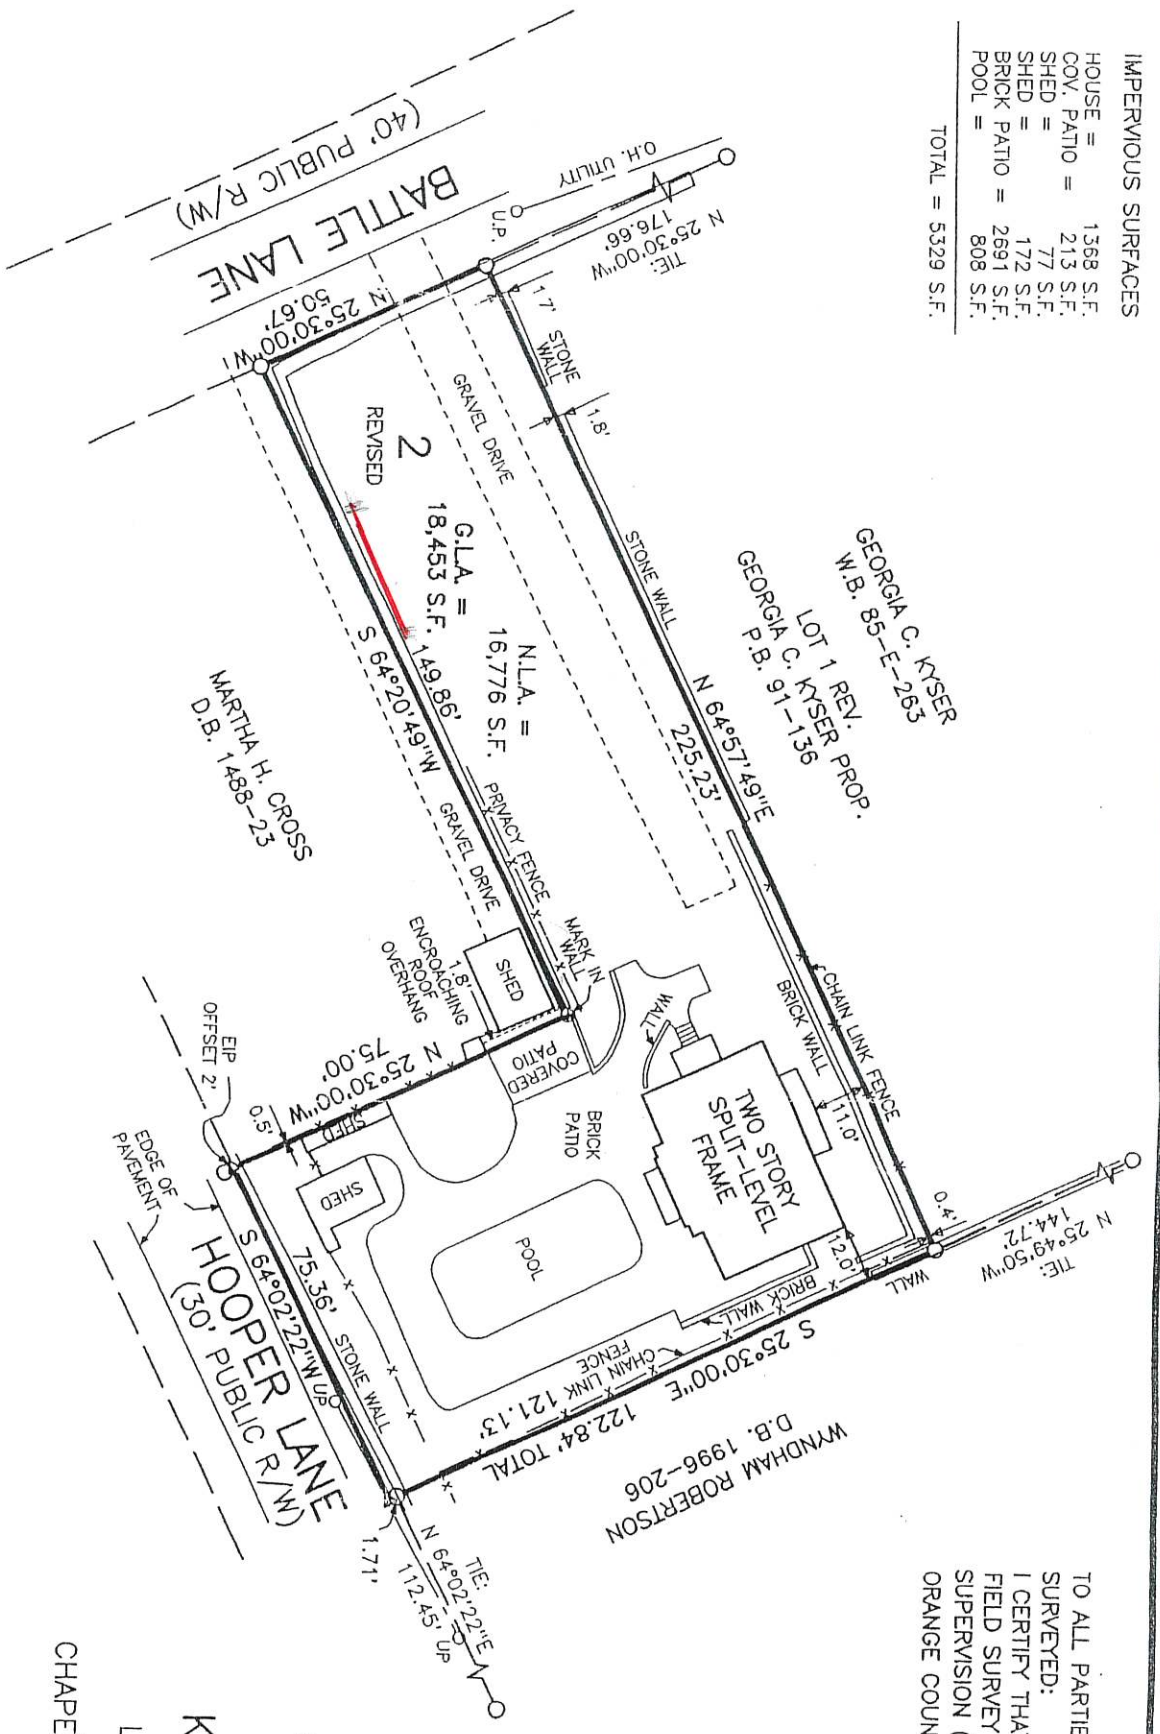

GEORGIA C. KYSER
W.B. 85-E-263
LOT 1 REV. PROP.
GEORGIA C. KYSER PROP.
P.B. 91-136


WYNDHAM ROBERTSON
D.B. 1996-206

AS-BUILT SURVEY
PROPERTY OF
KIMBERLY KYSER
LOT 2, GEORGIA KYSER
T.M. 7.74.E.2B
CHAPEL HILL TWP. ORANGE CO.
NORTH CAROLINA




TO ALL PARTIES INTERESTED IN TITLE TO PREMISES SURVEYED:
I CERTIFY THAT THIS MAP WAS DRAWN FROM AN ACTUAL FIELD SURVEY PERFORMED UNDER MY DIRECTION AND SUPERVISION (REFERENCE OF RECORD: P.B. 91-136 ORANGE COUNTY REGISTRY).

SCALE: 1" = 40'

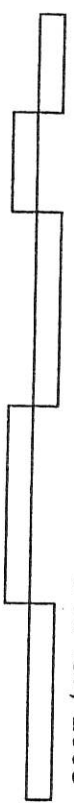

JAN. 26, 2005

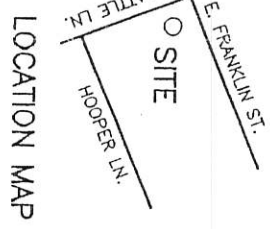

FREEHOLD LAND SURVEYS, INC.
P.O. BOX 188 CARRBORO NORTH CAROLINA 27510