

# TOWN OF CHAPEL HILL

COMMUNITY DESIGN COMMISSION



January 22, 2019 - Minor Alteration Request

---

## HILLSTONE CHAPEL HILL

1000 & 2000 Novus Lane  
Chapel Hill, North Carolina

PIN #'s : 9799-36-6631, 9799-36-7662, 9799-46-1235

**JDAVIS** >

Architect / Land Planner / Landscape Architect

1. Relocation of Gas Meters onto Exterior Building Elevations
2. Building 1 - Transformer Design & Orientation




## 1. Relocation of Gas Meters onto Exterior Building Elevations

### **ISSUE:**

*PSNC originally approved the CDC & FDP approved locations for the gas meters within the building footprints. After construction began, PSNC rescinded this approval, stating they could not install or maintain meters within the building footprint.*

### **PROPOSED SOLUTION:**


**Relocate meters to exterior building elevations accessible by PSNC and away from street views immediately adjacent to the site.**

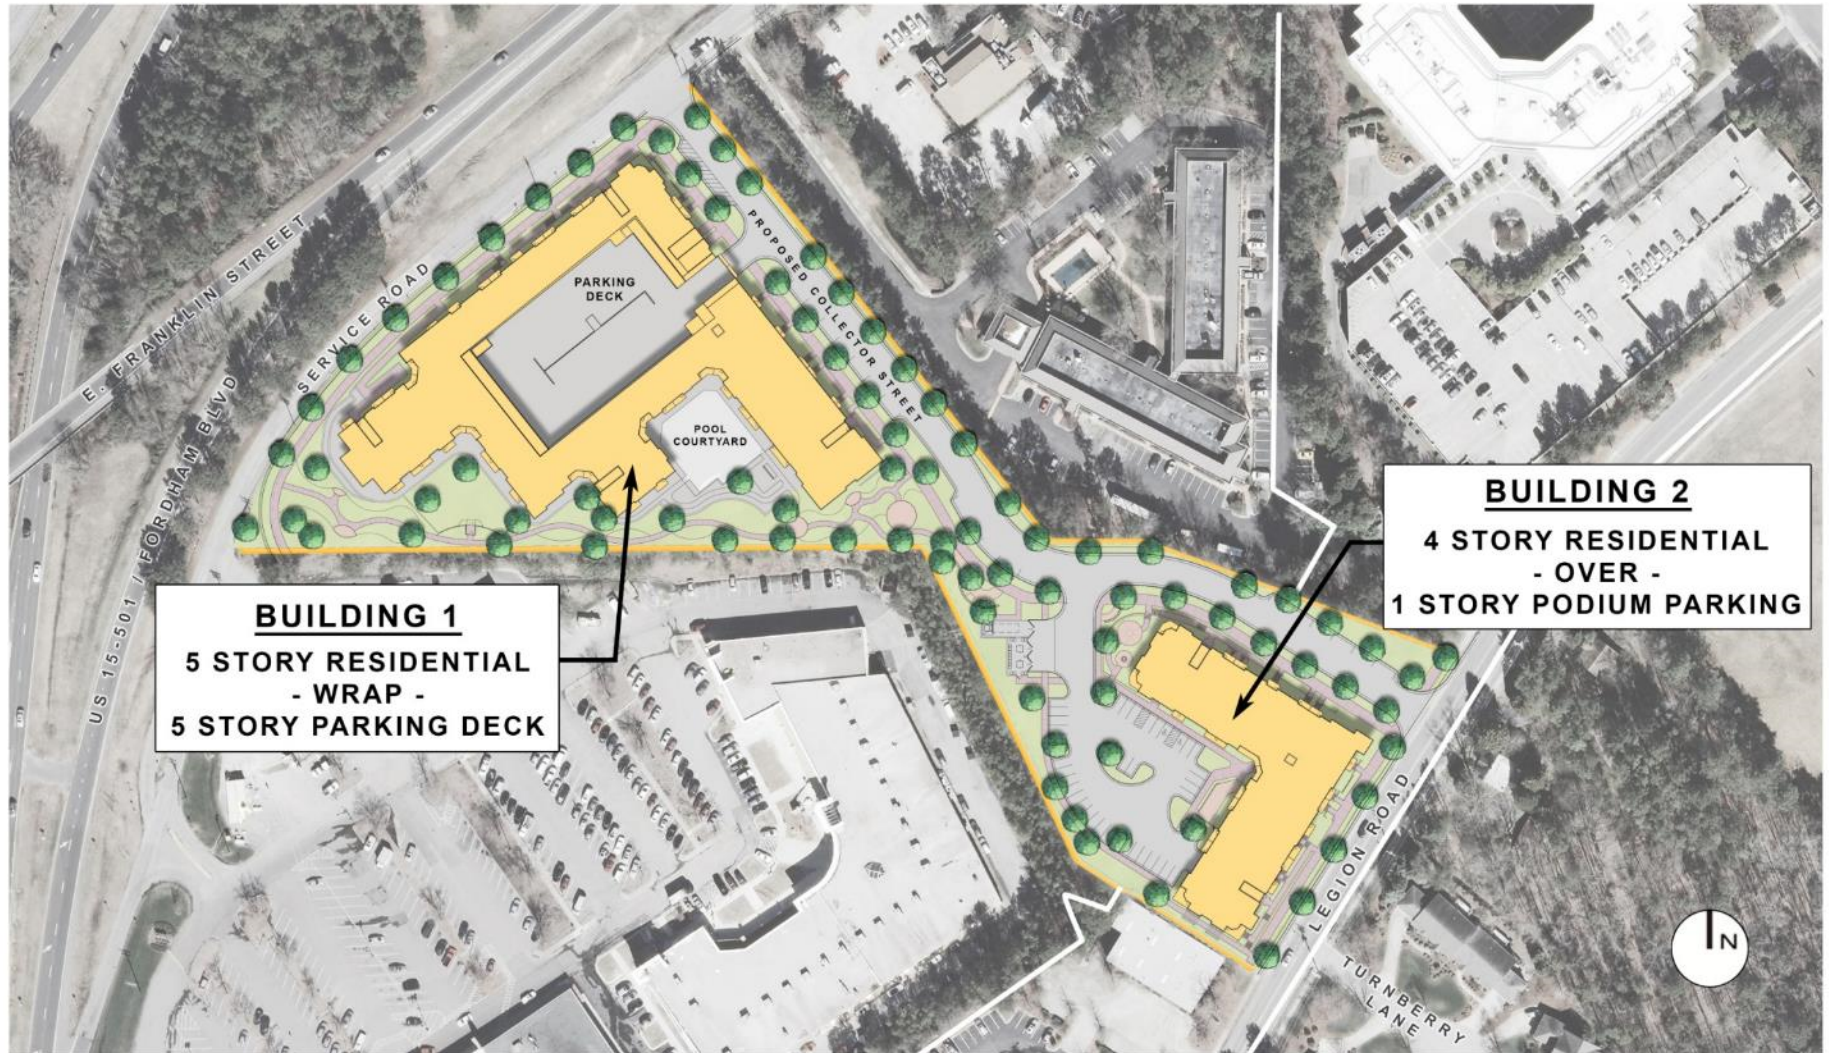

## PROPOSED SITE PLAN

NTS



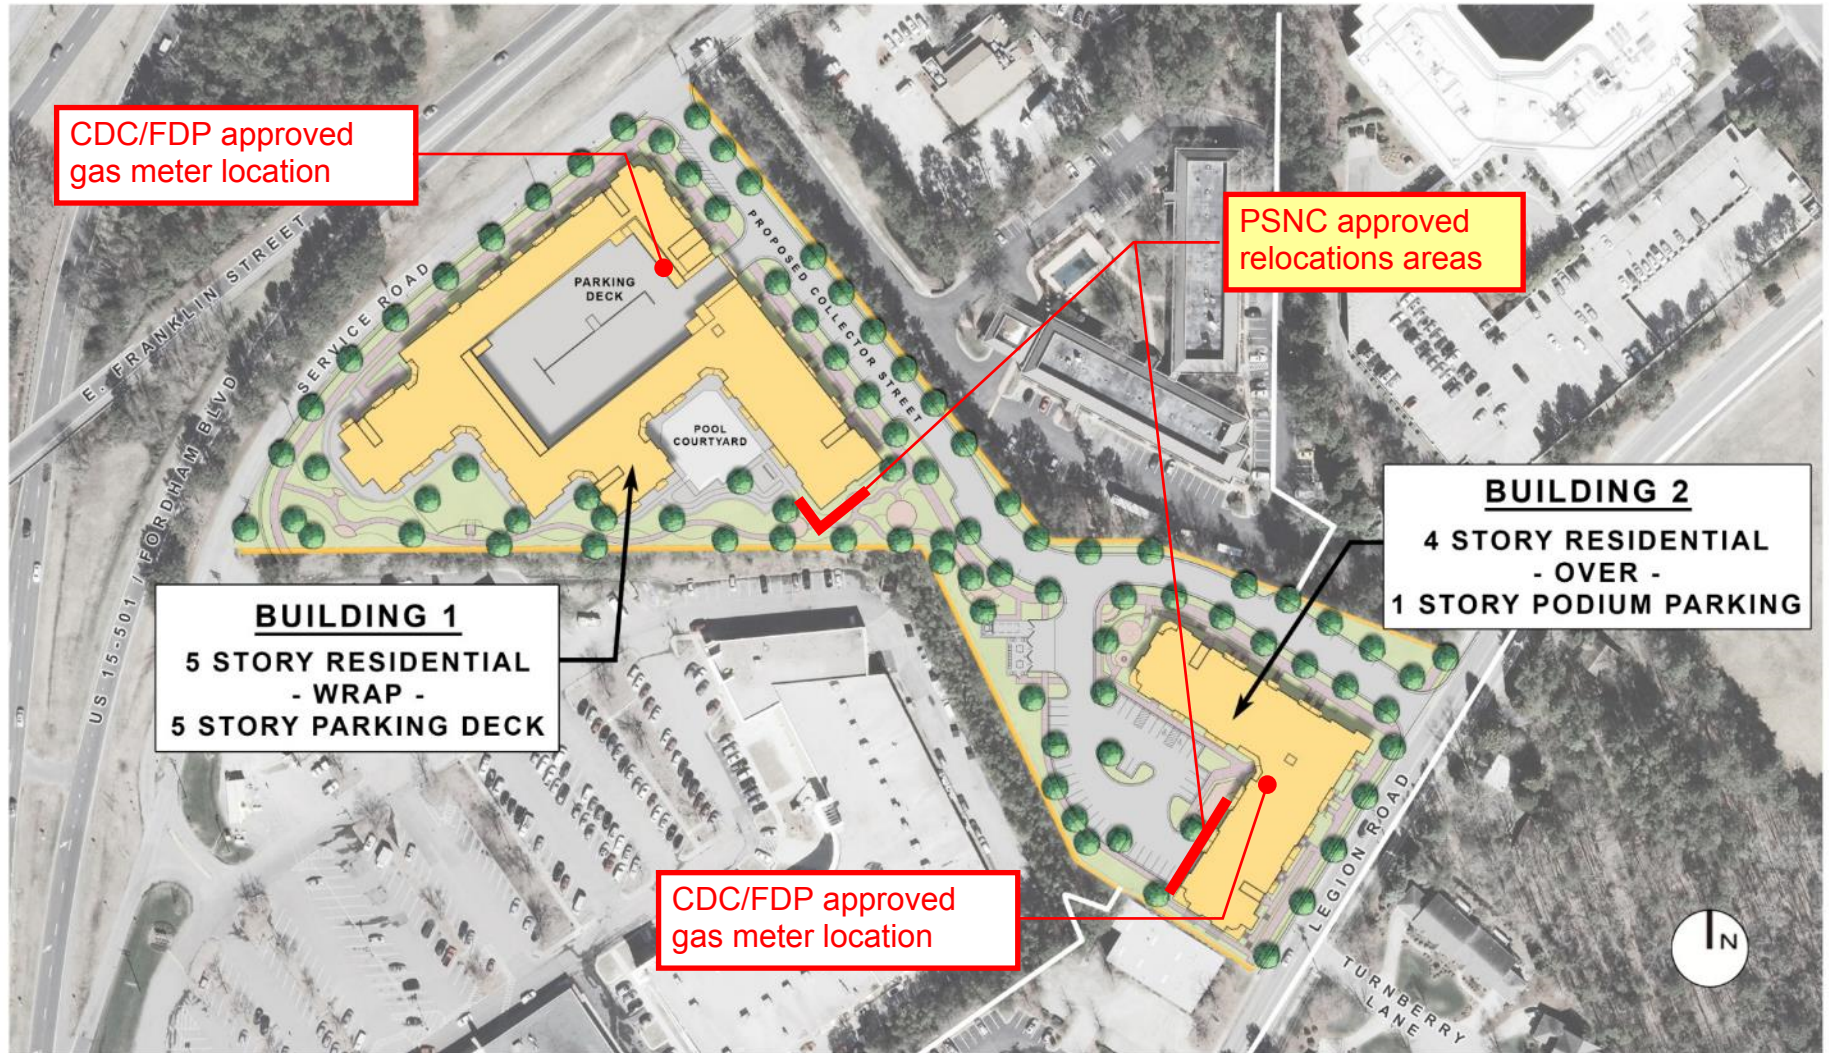

## PROPOSED SITE PLAN

NTS






<b>SUBJECT</b>	<b>SECTION</b>	<b>PAGE #</b>
METER SET INSTALLATION STANDARDS	SU-205	4 of 63
<b>TITLE</b>	<b>DATE</b>	
FIELD INSTALLATION GUIDE	<b>ISSUED</b>	12/05/2008
	<b>EFFECTIVE</b>	01/02/2009

### Standard Drawing A-425-7-1

Meter Info	
Model	Type
AL-425	3124
R-415	3232

ERT Programming	
Number of Dials	4 Dial
Drive Rate	2 CF
PCOMP	Non-Comp
PCOMP Value	1.0000

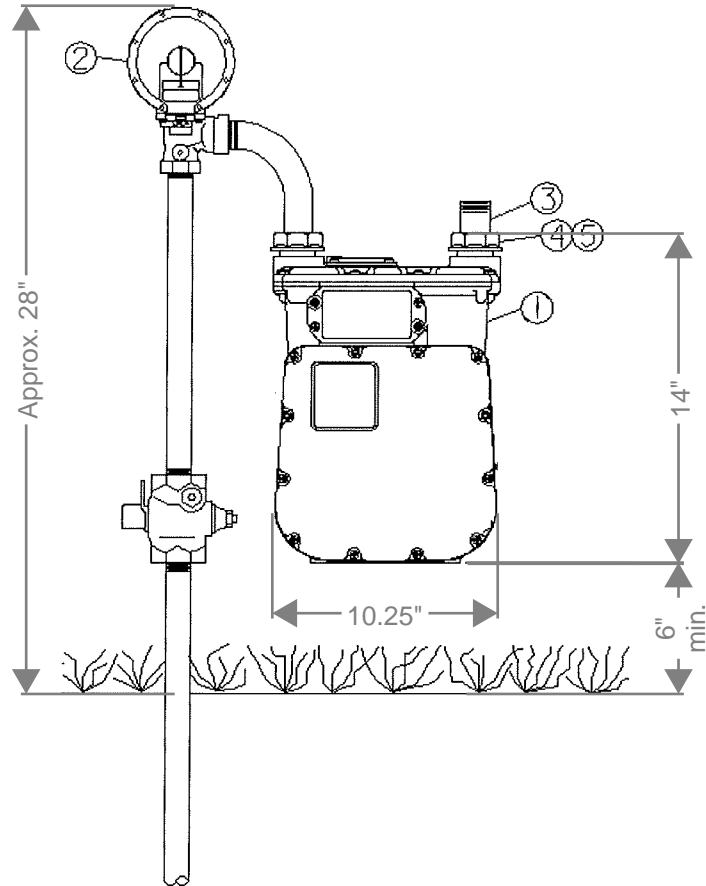

Pressures	
Customer Delivery	7" WC
Metering Pressure	7" WC
Minimum Inlet	30 PSIG
Maximum Inlet	60 PSIG

Total Connected Load	
1 Appliance	251-425 CFH
2 Appliances or more	314-531 CFH

Notes

# SERVICE ROAD

CDC/FDP approved gas meter location

Pedestrian Plaza

Dog Park

Pedestrian Connector

Pool Courtyard

Vehicle access to deck through building

Building Pass-thru

NOVUS LANE

Proposed relocation of gas meter for CDC review/approval

Locations on building elevations identified by PSNC as adequate for meter relocation

**NOTES**

**RATED WALL LEGEND**

- 1 HR RATED BEARING WALL (PER UL 1208 @ EXTERIOR WALL & UL 1205 @ INTERIOR)
- 2 HR RATED BEARING WALL (PER UL 1207 @ EXTERIOR WALL & UL 1201 @ INTERIOR)
- 1 HR FIRE PARTITION (PER UL 1201 @ TENANT SEPARATION WALL)
- 1 HR FIRE BARRIER (PER UL 1203)
- 2 HR FIRE BARRIER (PER UL 1201)
- 2 HR FIRE BARRIER (PER UL 1203)
- 2 HR FIRE WALL (PER UL 1204)
- RATED SEMI-RECESSED FIRE EXTINGUISHER CABINET - SEE DETAIL: 6010-04-12

**ROOM DESIGNATIONS**

- S. STORAGE
- M. MECHANICAL
- E. ELECTRICAL
- R. RESTROOM
- V. VENDING

**KEY PLAN**

**BUILDING 1 - LEVEL 1 PLAN**  
SCALE: 1/16" = 1'-0"

**NOT FOR CONSTRUCTION**

GA2.01



Leon Group  
Hillstone - Building 1  
Chapel Hill, North Carolina



PROJECT	NOVUS	DATE
DESIGN/REVISION	1	
TOP SURVEY	1	
SCHEMATIC DEVELOPMENT	1	
PRELIMINARY SET	1	
PERMITS SET	1	
CONSTRUCTION	1	
AS-BUILT	1	
REVISIONS		
DATE		
BY		
CHECKED BY		
APPROVED BY		
DATE		







Locations on building elevation identified by PSNC as adequate for meter relocation



**EAST ELEVATION - BUILDING 1 FACING  
PEDESTRIAN CONNECTOR**

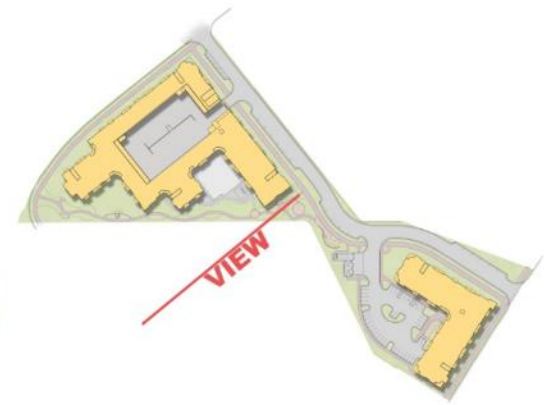


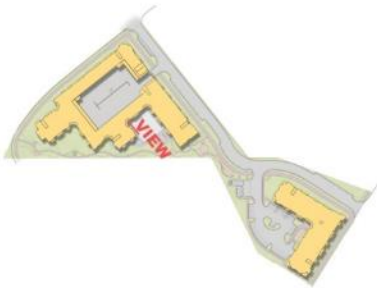

Locations on building elevation identified by PSNC as adequate for meter location

Proposed relocation of gas meter for CDC review/approval

## ELEVATIONS - BUILDING 1 AT POOL COURTYARD

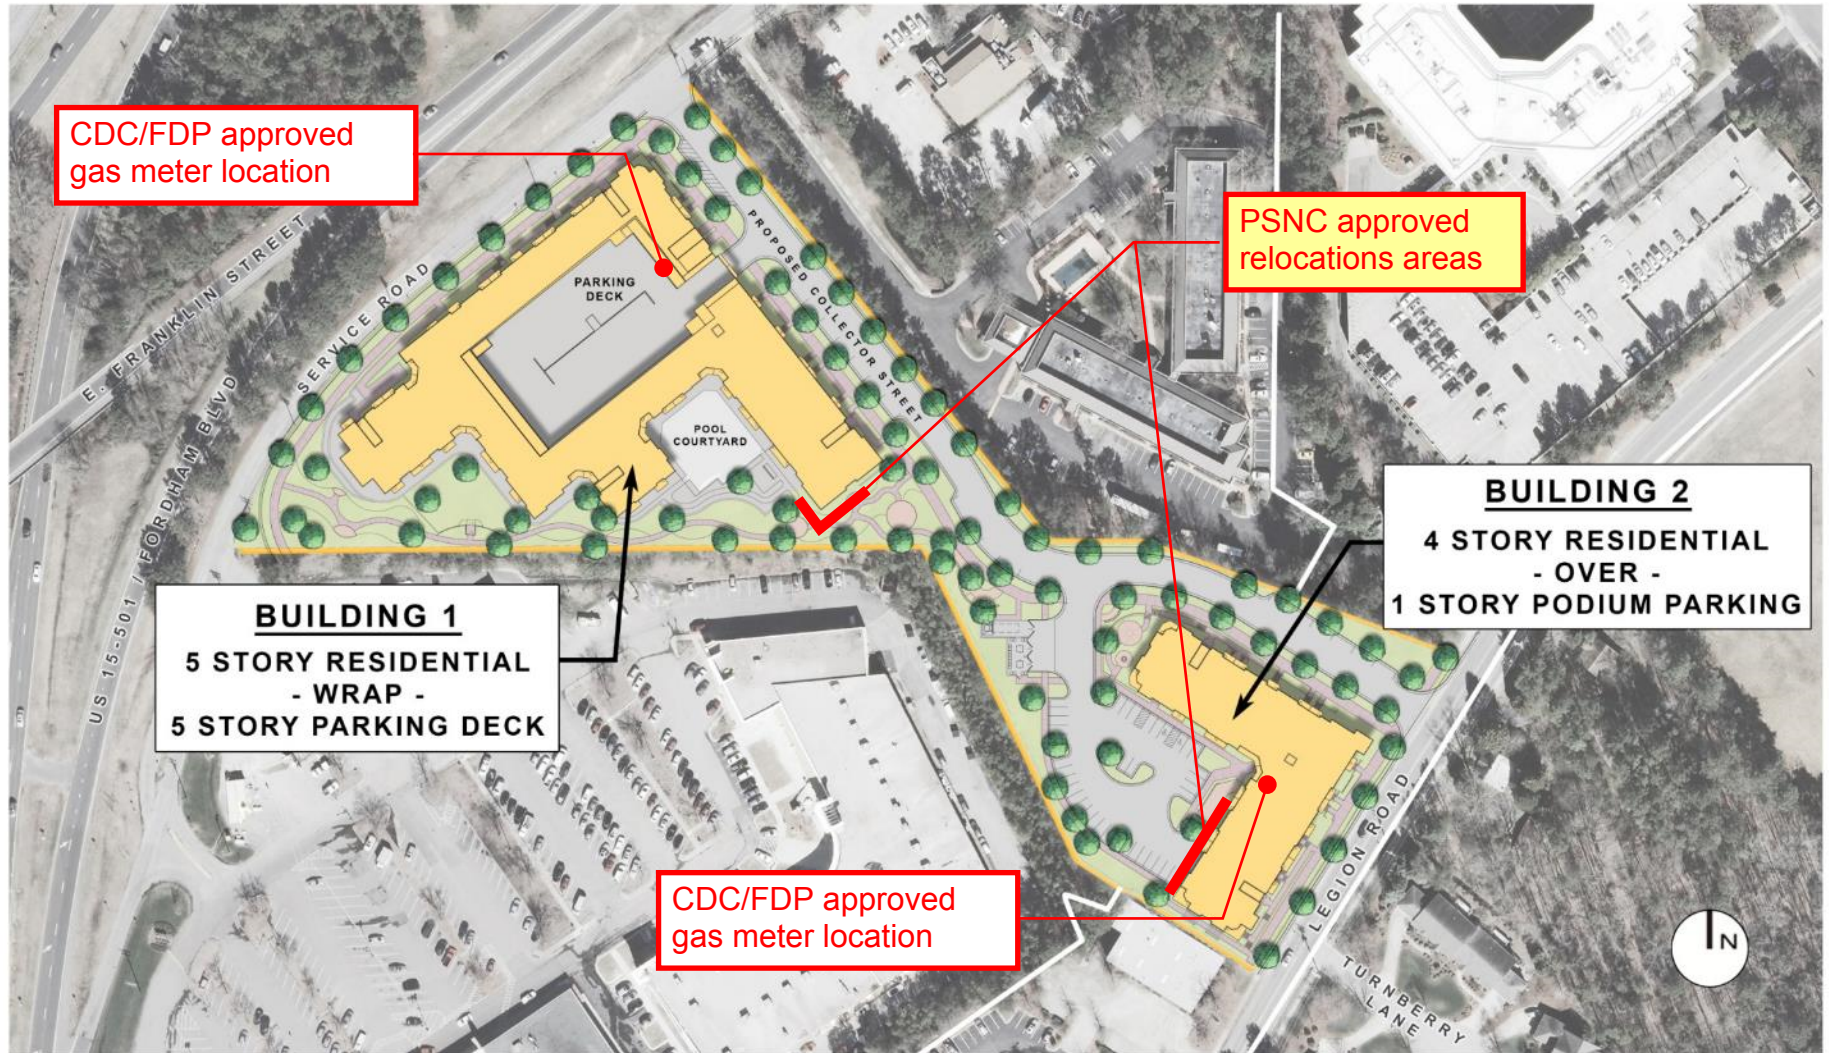

## PROPOSED SITE PLAN


NTS



Locations on building elevations identified by PSNC as adequate for meter relocation

Proposed relocation of gas meter for CDC review/approval

CDC/FDP approved gas meter location

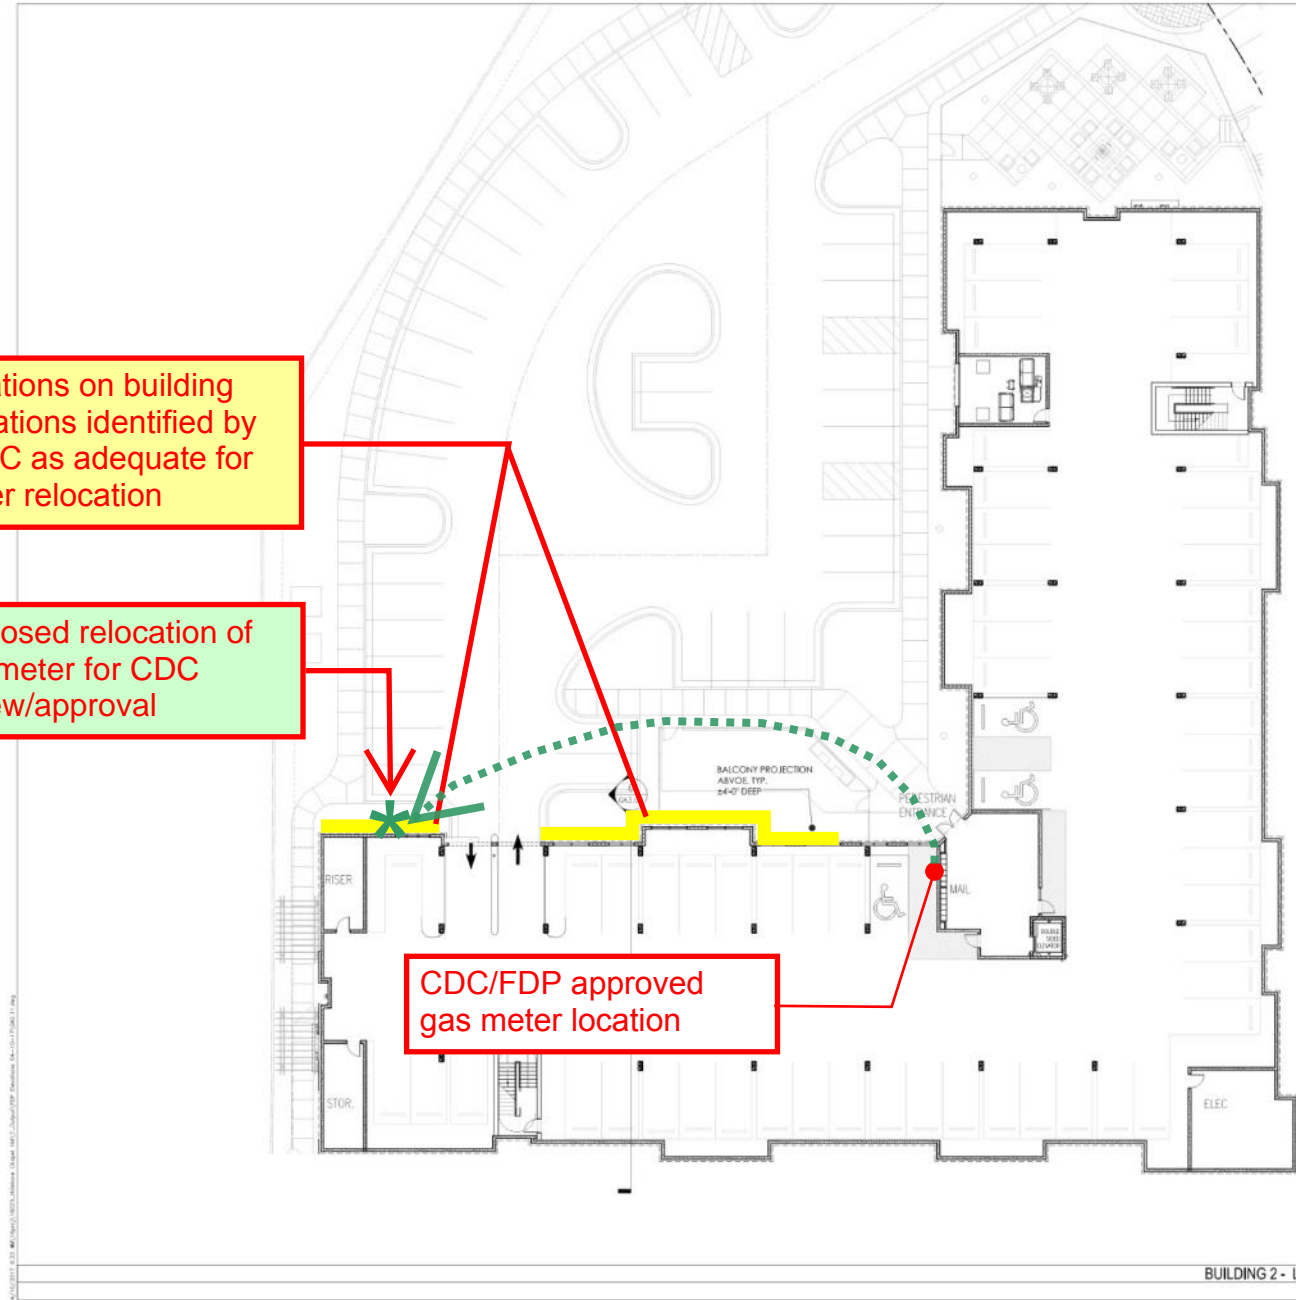

**NOTES**

**RATED WALL LEGEND**

- 1 HR RATED BEARING WALL (PER UL 1208 @ EXTERIOR WALL & UL 1205 @ INTERIOR)
- 2 HR RATED BEARING WALL (PER UL 1201 @ EXTERIOR WALL & UL 1201 @ INTERIOR)
- 1 HR FIRE PARTITION (PER UL 1201 @ TENANT SEPARATION WALL)
- 1 HR FIRE BARRIER (PER UL 1203)
- 2 HR FIRE BARRIER (PER UL 1201)
- 2 HR FIRE BARRIER (PER UL 1203)
- 2 HR FIRE WALL (PER UL 1204)
- RATED SEMI-RECESSED FIRE EXTINGUISHER CABINET - SEE DETAIL: 94-01-04-12

**ROOM DESIGNATIONS:**

- S. STORAGE
- M. MECHANICAL
- E. ELECTRICAL
- R. RESTROOM
- V. VENDING


**KEY PLAN**

**NOT FOR CONSTRUCTION**


PROJECT: NEW  
 GROUP: 200-0000000000  
 TOP SURVEY: 10/1/2017  
 DESIGN DEVELOPMENT: 10/1/2017  
 PERMITS: 10/1/2017  
 CONSTRUCTION: 10/1/2017  
 DATE: 10/1/2017

**BUILDING 2 - LEVEL 1 GARAGE PLAN**  
 SCALE: 3/32" = 1'-0"

**GA2.11**

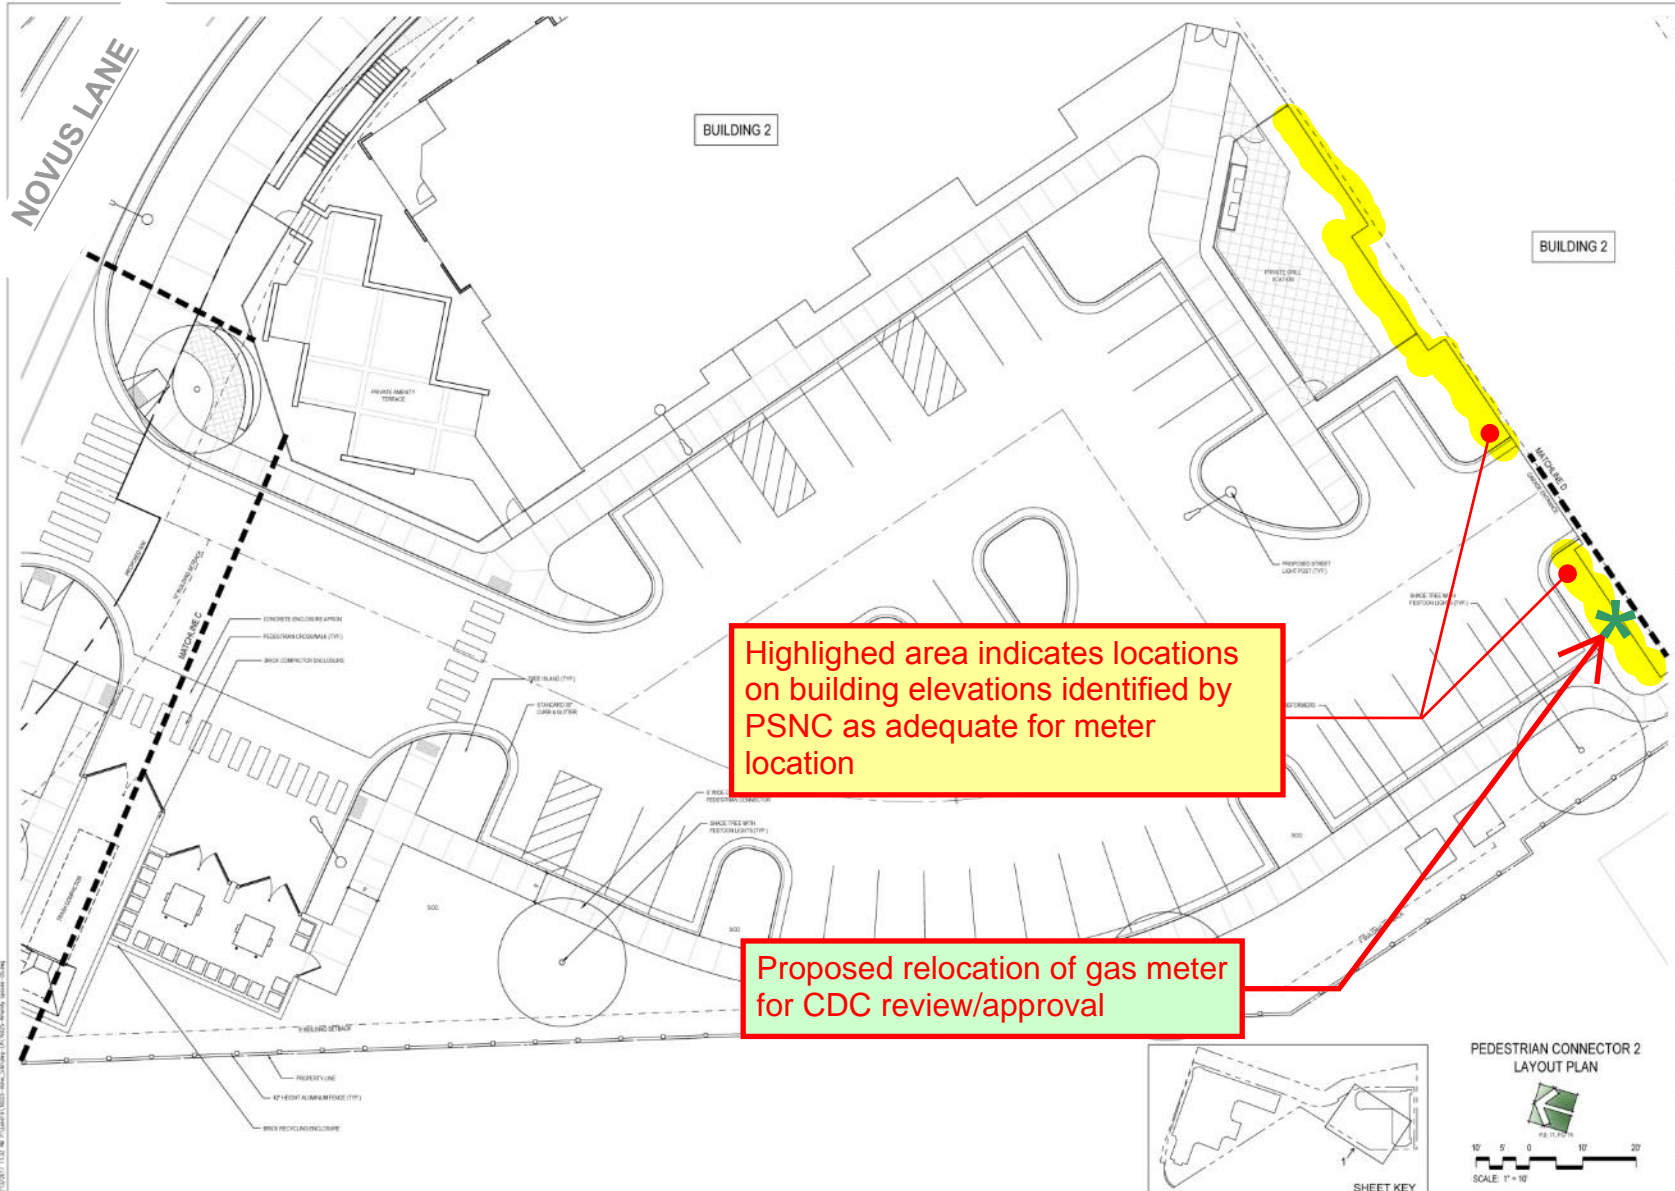

PROJECT	NO.02	DATE
ISSUE	FOR APPROVAL	12/02/2017
ISSUE	FOR APPROVAL	07/26/2017
ISSUE	FOR APPROVAL	02/28/2017
ISSUE	FOR APPROVAL	04/12/2017
REVISIONS	ISSUE	02/28/2017
DESIGNED BY	YOUNG	
CHECKED BY	YOUNG	
CONTRACT	PEDESTRIAN CONNECTOR 2	
LAYOUT PLAN		

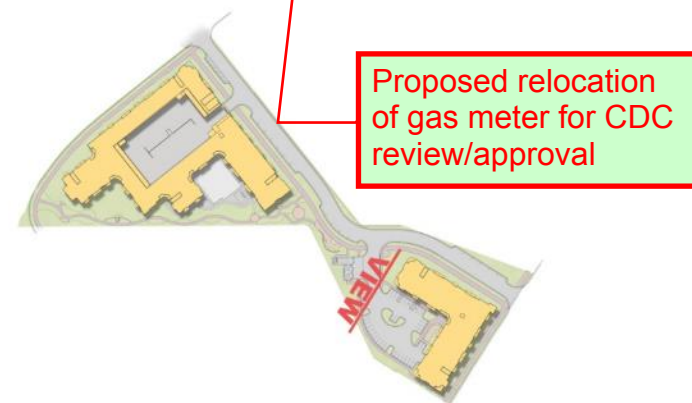

**WEST ELEVATION - BUILDING 2**






## 2. Building 1 - Transformer Design & Orientation

### **ISSUE:**

The original Building 1 design called for (2) transformers per the estimated electrical loads developed by the Engineer of Record for the project. Duke Energy is responsible for the final design of the site electrical service, which was not completed until AFTER construction began. The final Duke Energy Design requires (4) transformers which will require a larger pad footprint.


### **PROPOSED SOLUTION:**

Locate the (4) transformers in the previously approved locations. This thereby maintains a location away from street views immediately adjacent to the site, yet still accessible to Duke Energy for maintenance.

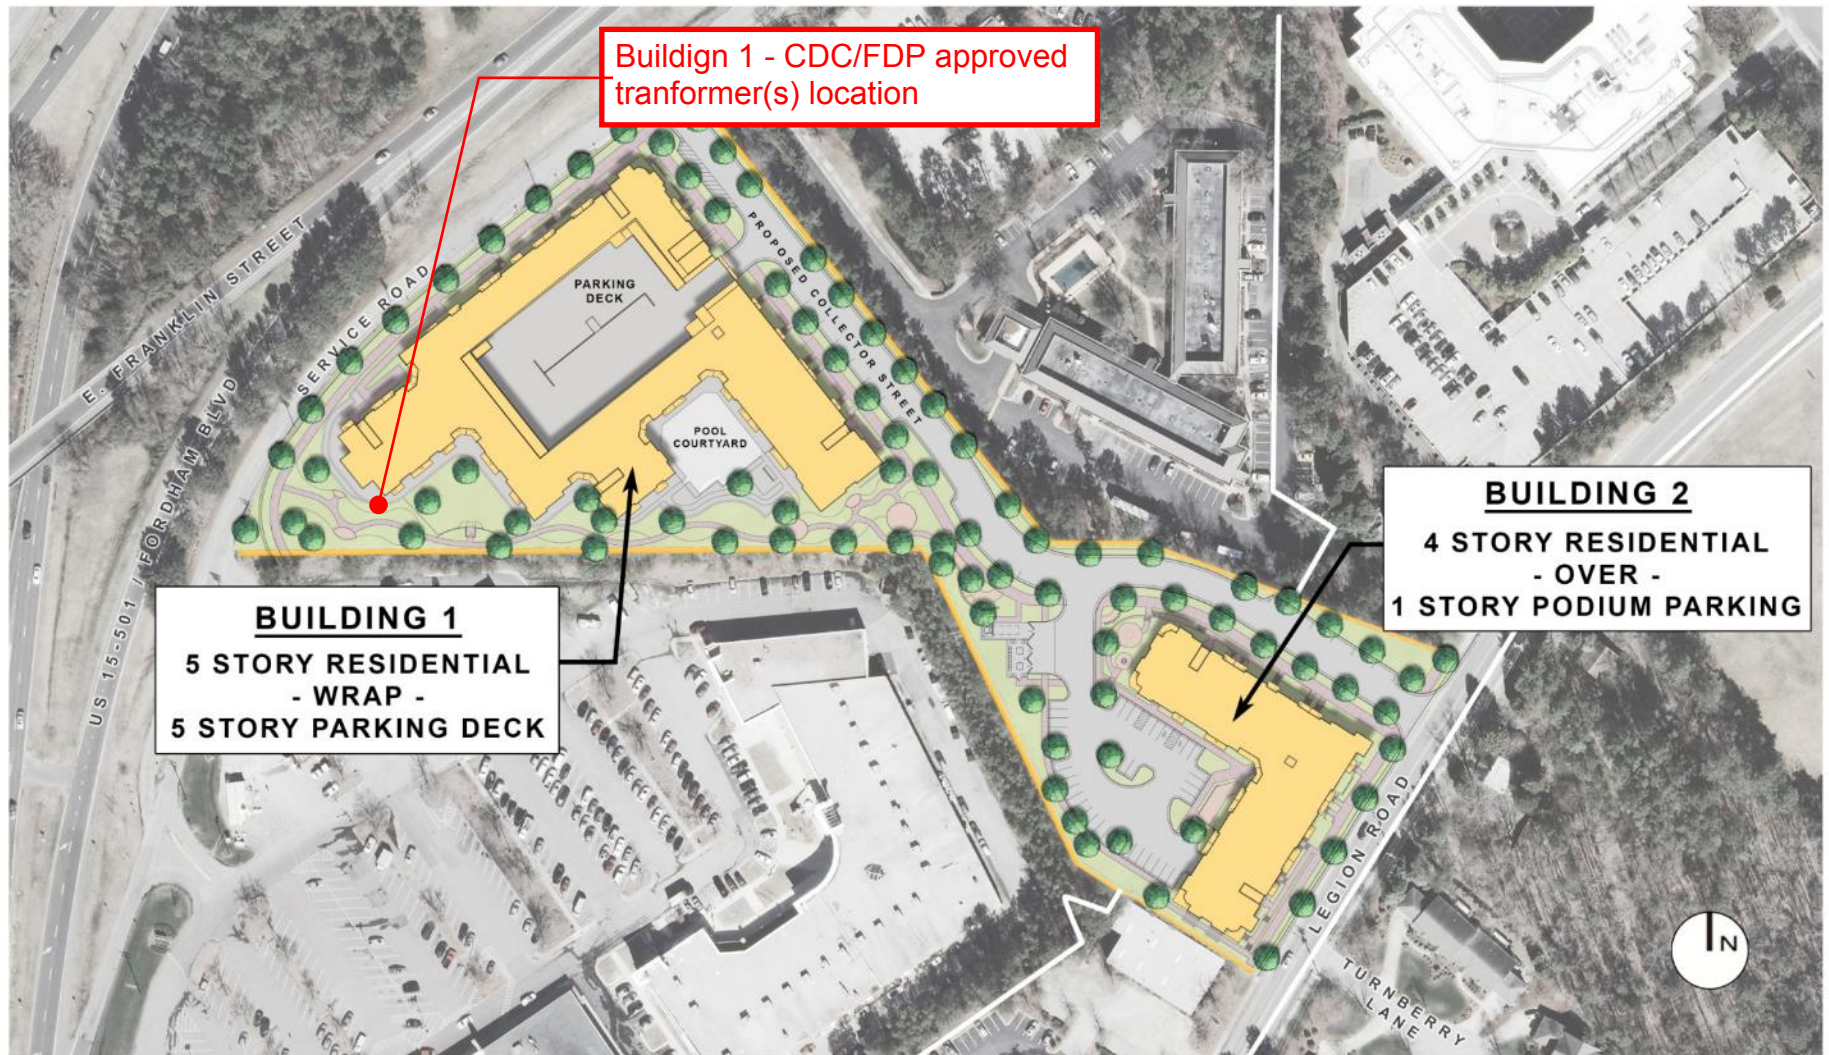

## PROPOSED SITE PLAN

NTS

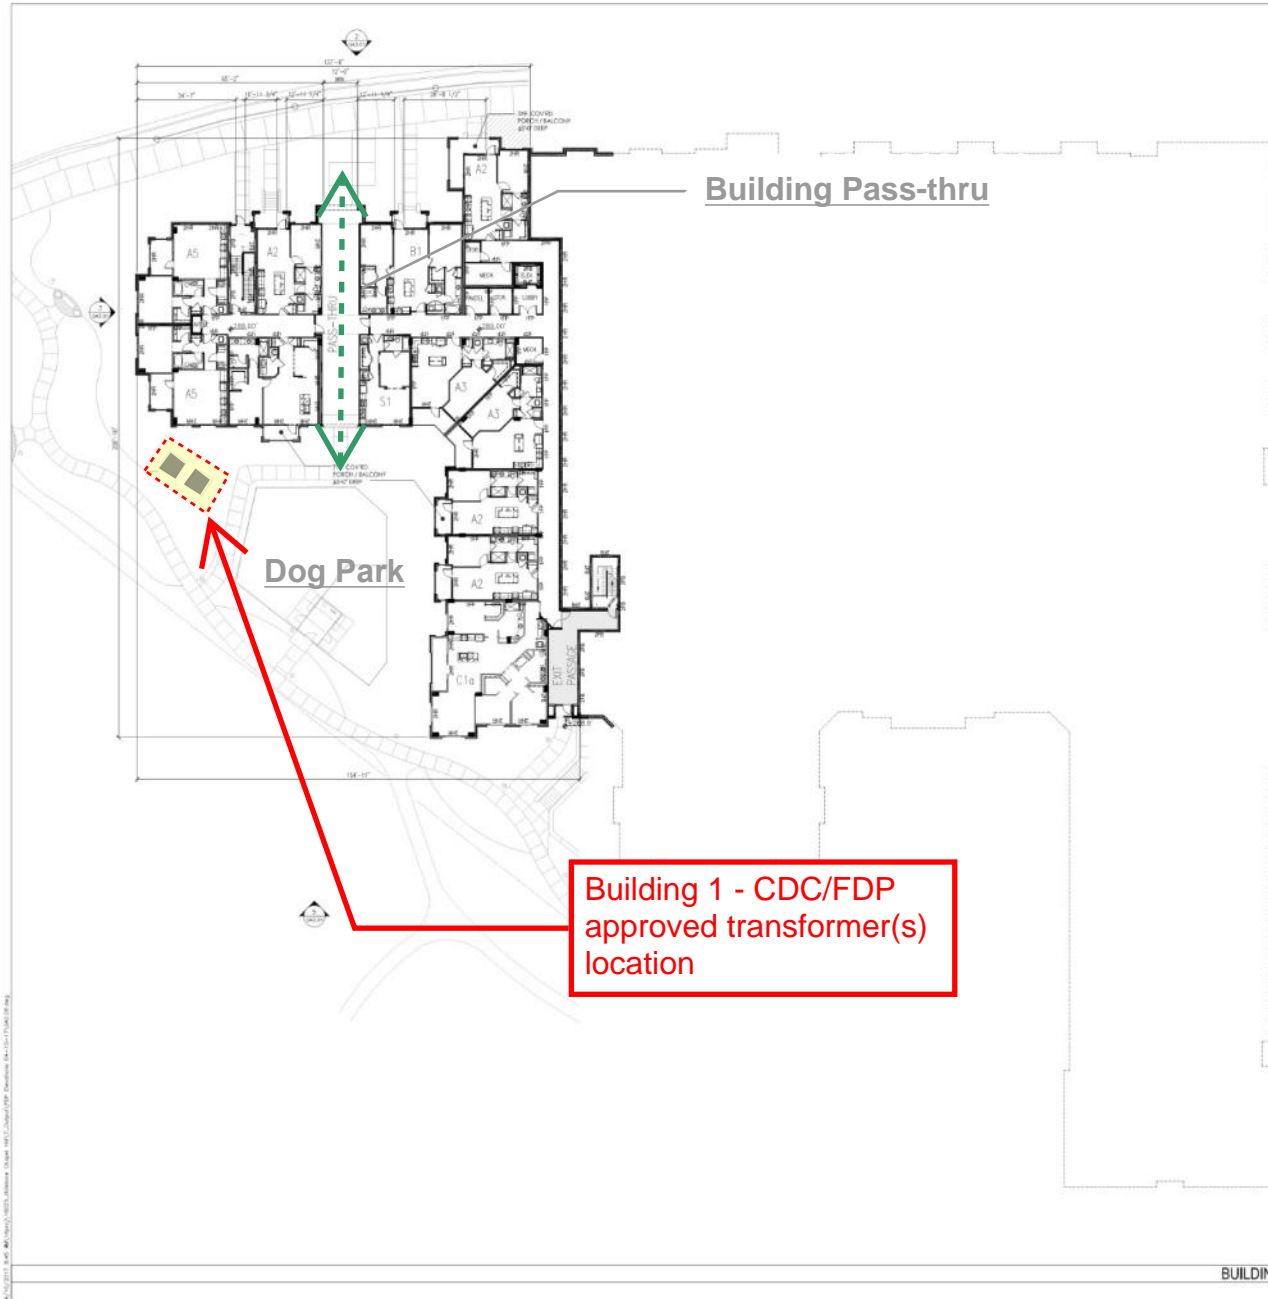

Building Pass-thru

Dog Park

Building 1 - CDC/FDP  
approved transformer(s)  
location

BUILDING 1 - LOWER LEVEL PLAN  
SCALE: 1/16" = 1'-0"

**NOTES**

**RATED WALL LEGEND**

- 1 HR RATED BEARING WALL (PER UL 1208 @ EXTERIOR WALL & UL 1205 @ INTERIOR)
- 2 HR RATED BEARING WALL (PER UL 1207 @ EXTERIOR WALL & UL 1201 @ INTERIOR)
- 1 HR FIRE PARTITION (PER UL 1201 @ TENANT SEPARATION WALL)
- 1 HR FIRE BARRIER (PER UL 1203)
- 2 HR FIRE BARRIER (PER UL 1201)
- 2 HR FIRE BARRIER (PER UL 1203)
- 2 HR FIRE WALL (PER UL 1204)
- RATED SEMI-RECESSED FIRE EXTINGUISHER CABINET - SEE DETAIL: RAC-01-A-12

**ROOM DESIGNATIONS**

- S. STORAGE
- M. MECHANICAL
- E. ELECTRICAL
- R. RESTROOM
- V. VENDING

**KEY PLAN**

**REVISIONS**

NO.	DESCRIPTION	DATE
1	ISSUED FOR DESIGN	
2	FOR CONSTRUCTION	
3	FOR CONSTRUCTION	
4	FOR CONSTRUCTION	
5	FOR CONSTRUCTION	
6	FOR CONSTRUCTION	
7	FOR CONSTRUCTION	
8	FOR CONSTRUCTION	
9	FOR CONSTRUCTION	
10	FOR CONSTRUCTION	

**PROJECT INFORMATION**

PROJECT	NO.	DATE
PROJECT	NO.	DATE
Leon Group  
Hillstone - Building 1  
Chapel Hill, North Carolina

NOT FOR  
CONSTRUCTION



GA2.00



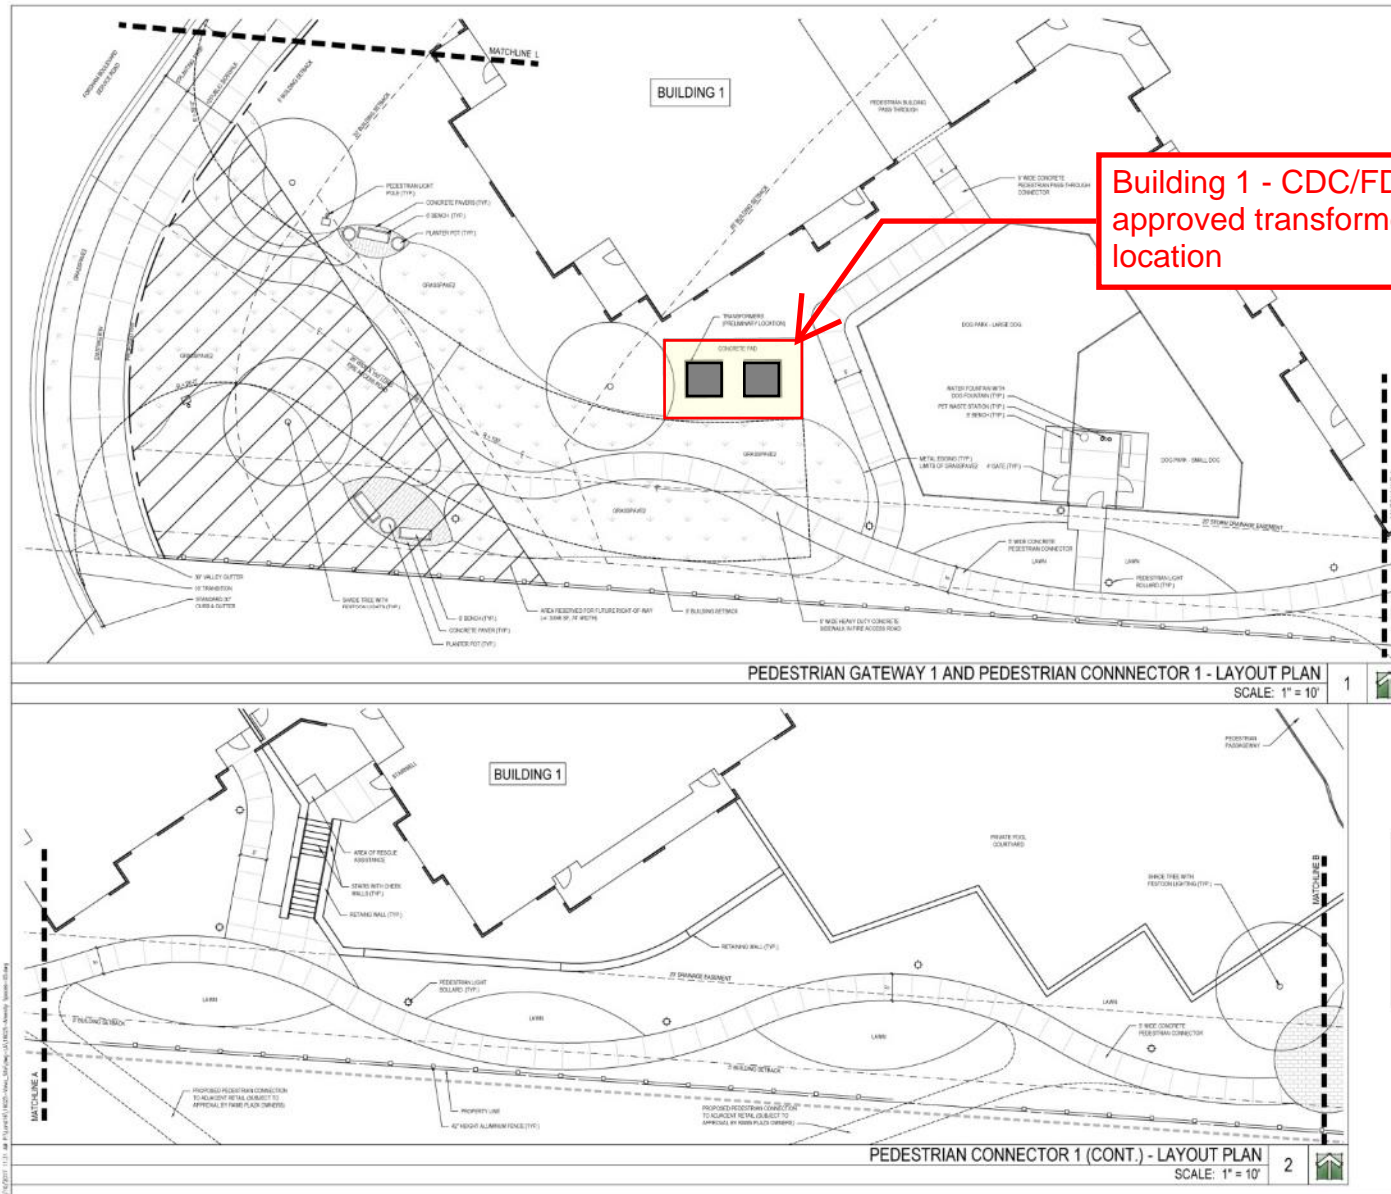

Building 1 - CDC/FDP  
approved transformer(s)  
location



Leon Capital Group  
Hillstone Chapel Hill  
1730 Fordham Blvd.  
Town of Chapel Hill, North Carolina 27514

PRELIMINARY


FOR REVIEW ONLY  
NOT FOR  
CONSTRUCTION

PROJECT	DATE
PROJ. NAME	03.03.2014
PROJ. NO.	03.03.2014
PROJ. 1	03.03.2014
PROJ. 2	03.03.2014
PROJ. 3	03.03.2014
PROJ. 4	03.03.2014
PROJ. 5	03.03.2014
PROJ. 6	03.03.2014
PROJ. 7	03.03.2014
PROJ. 8	03.03.2014
PROJ. 9	03.03.2014
PROJ. 10	03.03.2014

DESIGNED BY	DATE
DESIGNED BY	03.03.2014
CHECKED BY	03.03.2014
APPROVED BY	03.03.2014
CONTRACT	03.03.2014
CONTRACT NO.	03.03.2014
CONTRACT VALUE	03.03.2014
CONTRACT TYPE	03.03.2014
CONTRACT STATUS	03.03.2014
CONTRACT DESCRIPTION	03.03.2014
CONTRACT LOCATION	03.03.2014


LA5.01

# DESIGN ALTERNATE 4: BLOCK PERIMETER AT BUILDING 1 ORIGINAL APPROVED PLAN LAYOUT

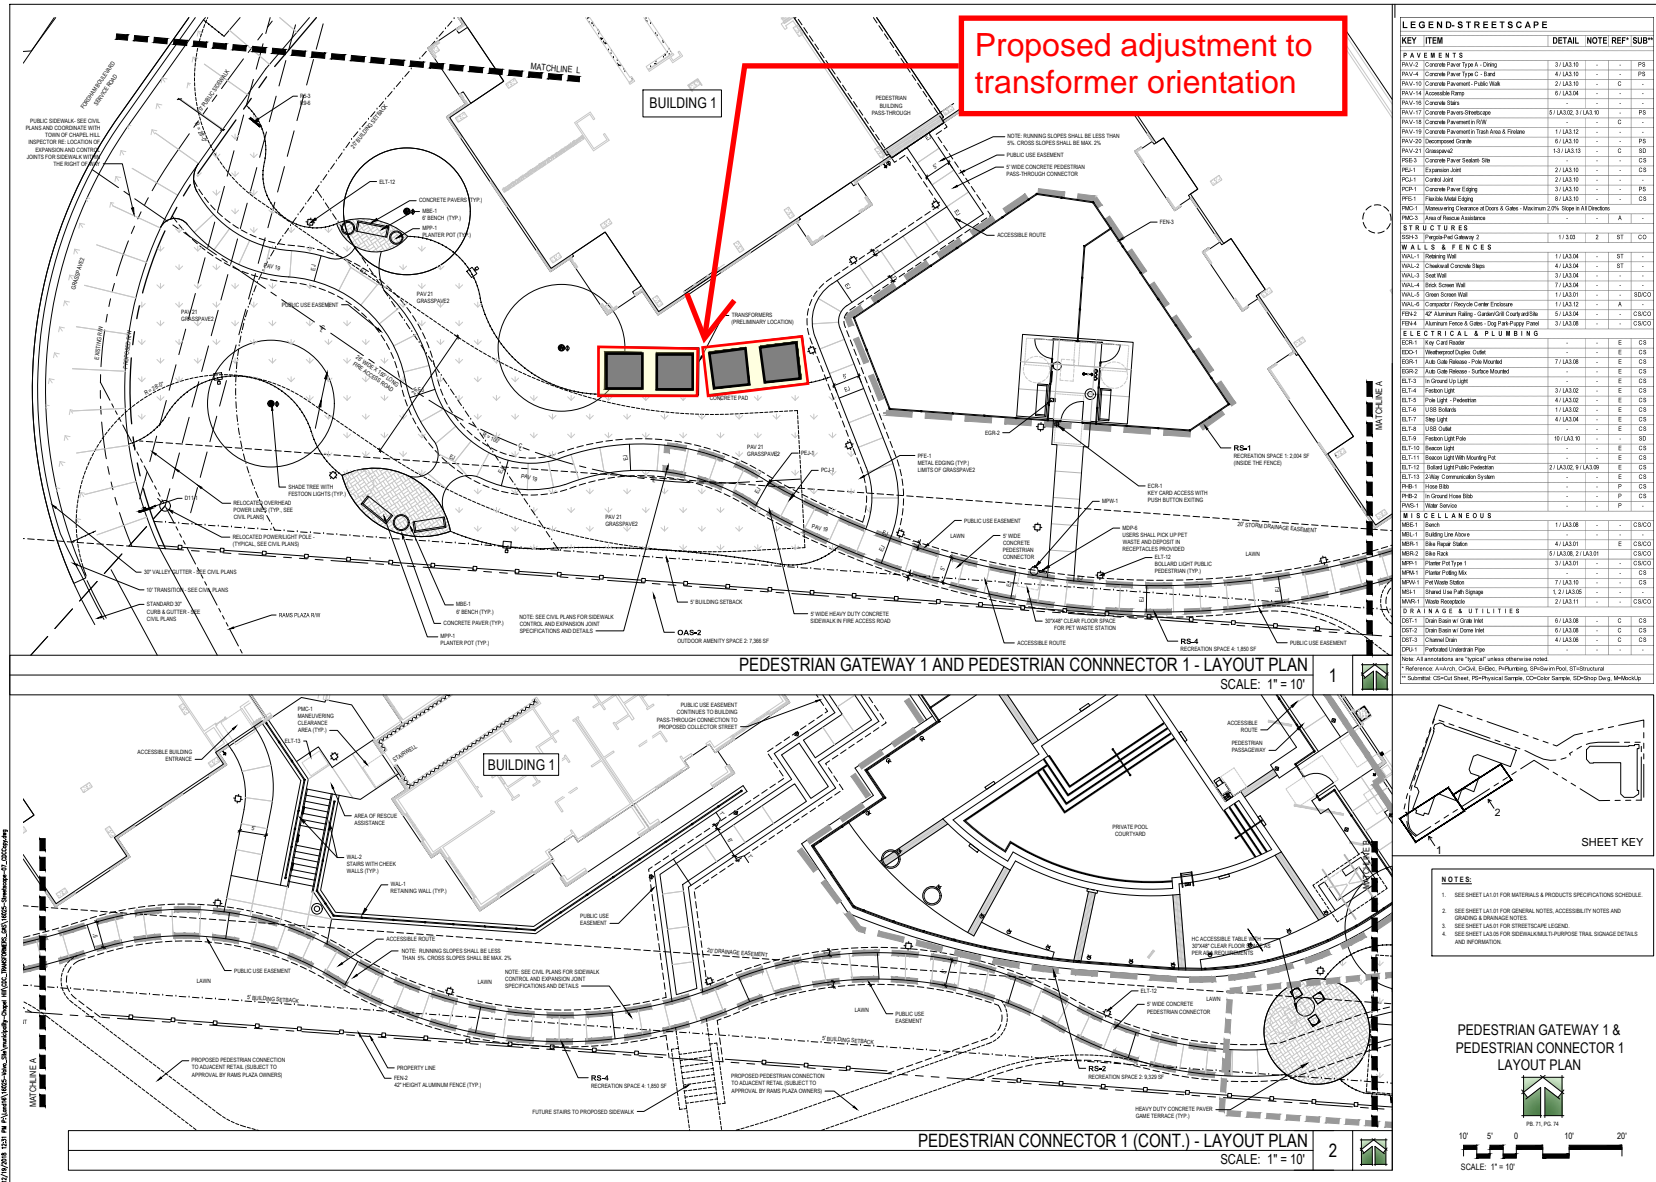

**PROPOSED MODIFICATION TO TRANSFORMER LAYOUT**



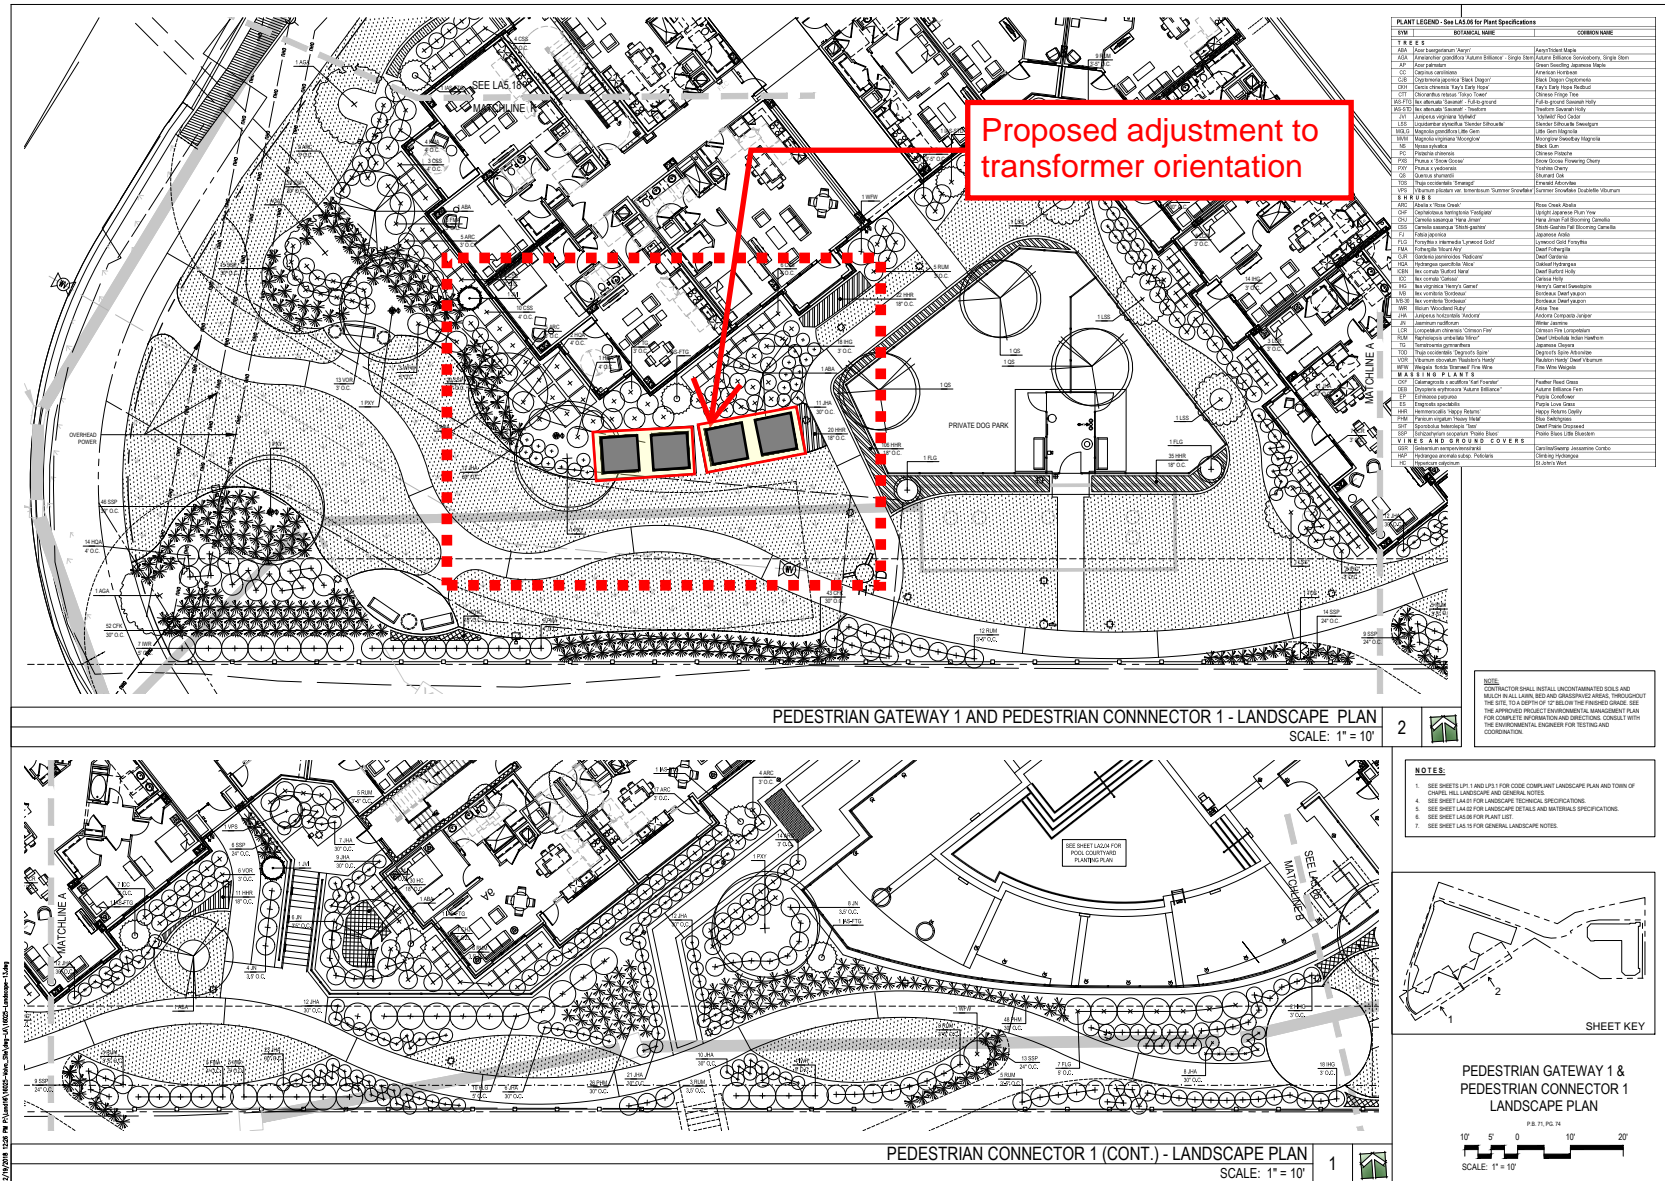

**PROPOSED ADJUSTMENT TO LANDSCAPE SCREENING SURROUND TRANSFORMERS**





**BEFORE**



**AFTER**

## BEFORE - AFTER LANDSCAPE ADJUSTMENTS