

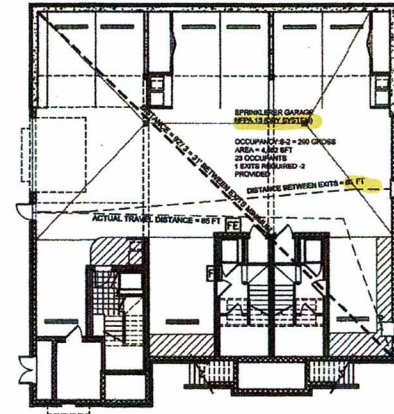
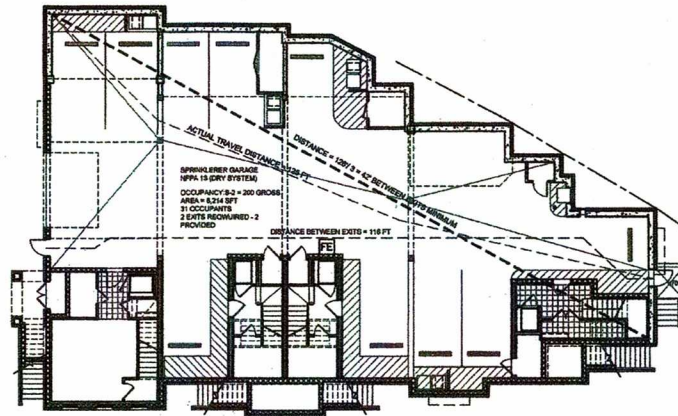


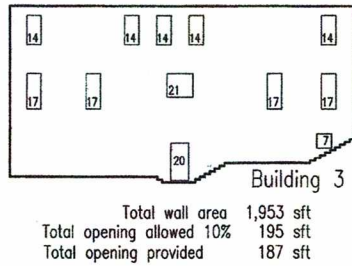

8/8/2017

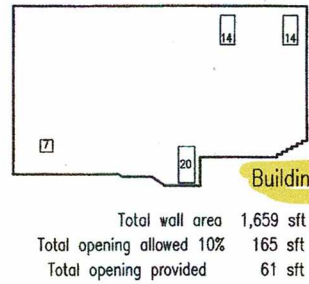

BUILDING 2 & 3 ALLOWABLE OPENINGS
SCALE: 1/16" = 1'-0"




6

BUILDING 4 -- GARAGE PLAN
SCALE: 1/16" = 1'-0"

4

BUILDING 2 -- GARAGE PLAN
SCALE: 1/16" = 1'-0"

3

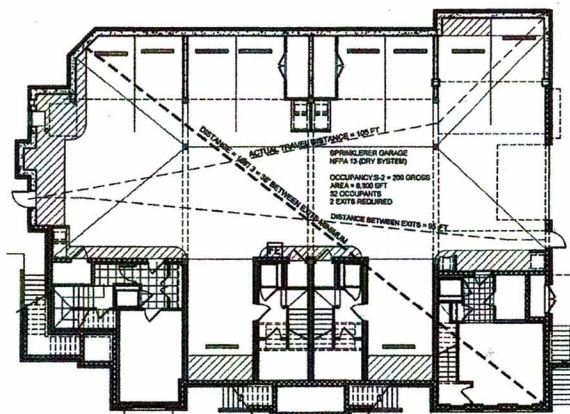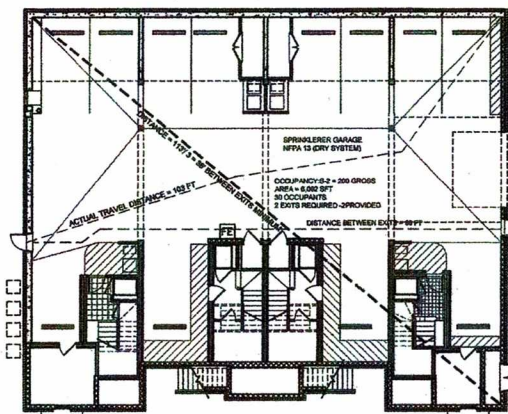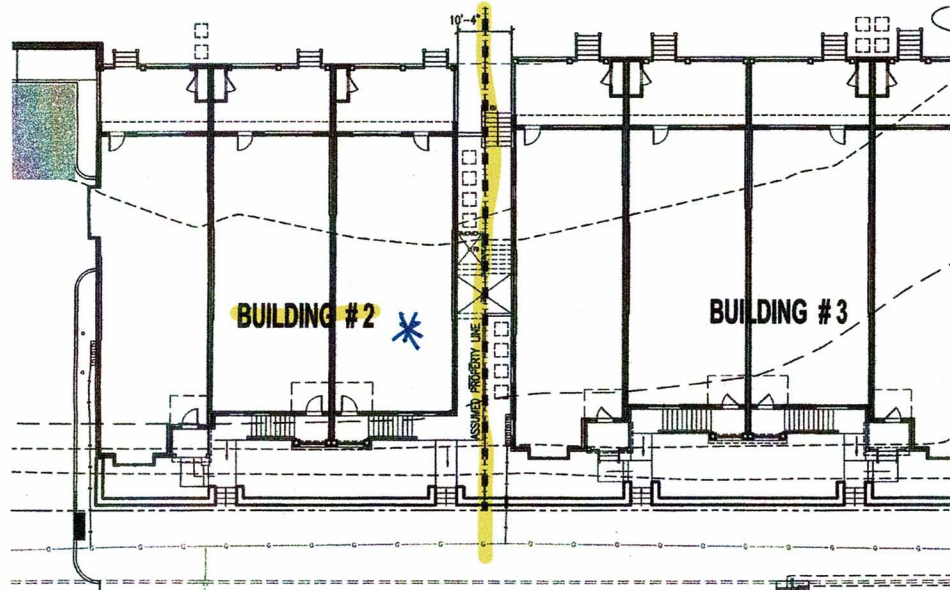

BUILDING 2 & 3 ALLOWABLE OPENINGS
SCALE: 1/16" = 1'-0"

5

BUILDING 3 -- GARAGE PLAN
SCALE: 1/16" = 1'-0"

2

BUILDING 1 -- GARAGE PLAN
SCALE: 1/16" = 1'-0"


1

These plans have been reviewed for code compliance. This plan review does not relieve the contractor of their responsibility to comply with all applicable codes. The issuance of a permit based on these plans shall not prevent the building official from thereafter requiring a correction of errors in plans, construction or violations of the code. This copy of the plans must be kept at the site of work and shall be open to inspection by the building official or their authorized representative

Permit #15508
Unit 203 only - Building 2
Full set of drawings, see Permit # 11013



Murray Hill Parcel 20
Chapel Hill, North Carolina

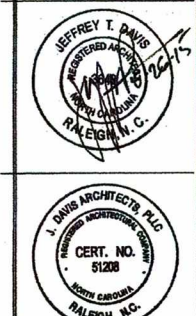

PROJECT:	13080	DATE	
ISSUE:			
REVISIONS:	PERMIT SET	05-28-15	
DRAWN BY:			
CHECKED BY:			
CONTENT:	BUILDING CODE ANALYSIS		
SCALE:	1/16"=1'-0"		

A0.03