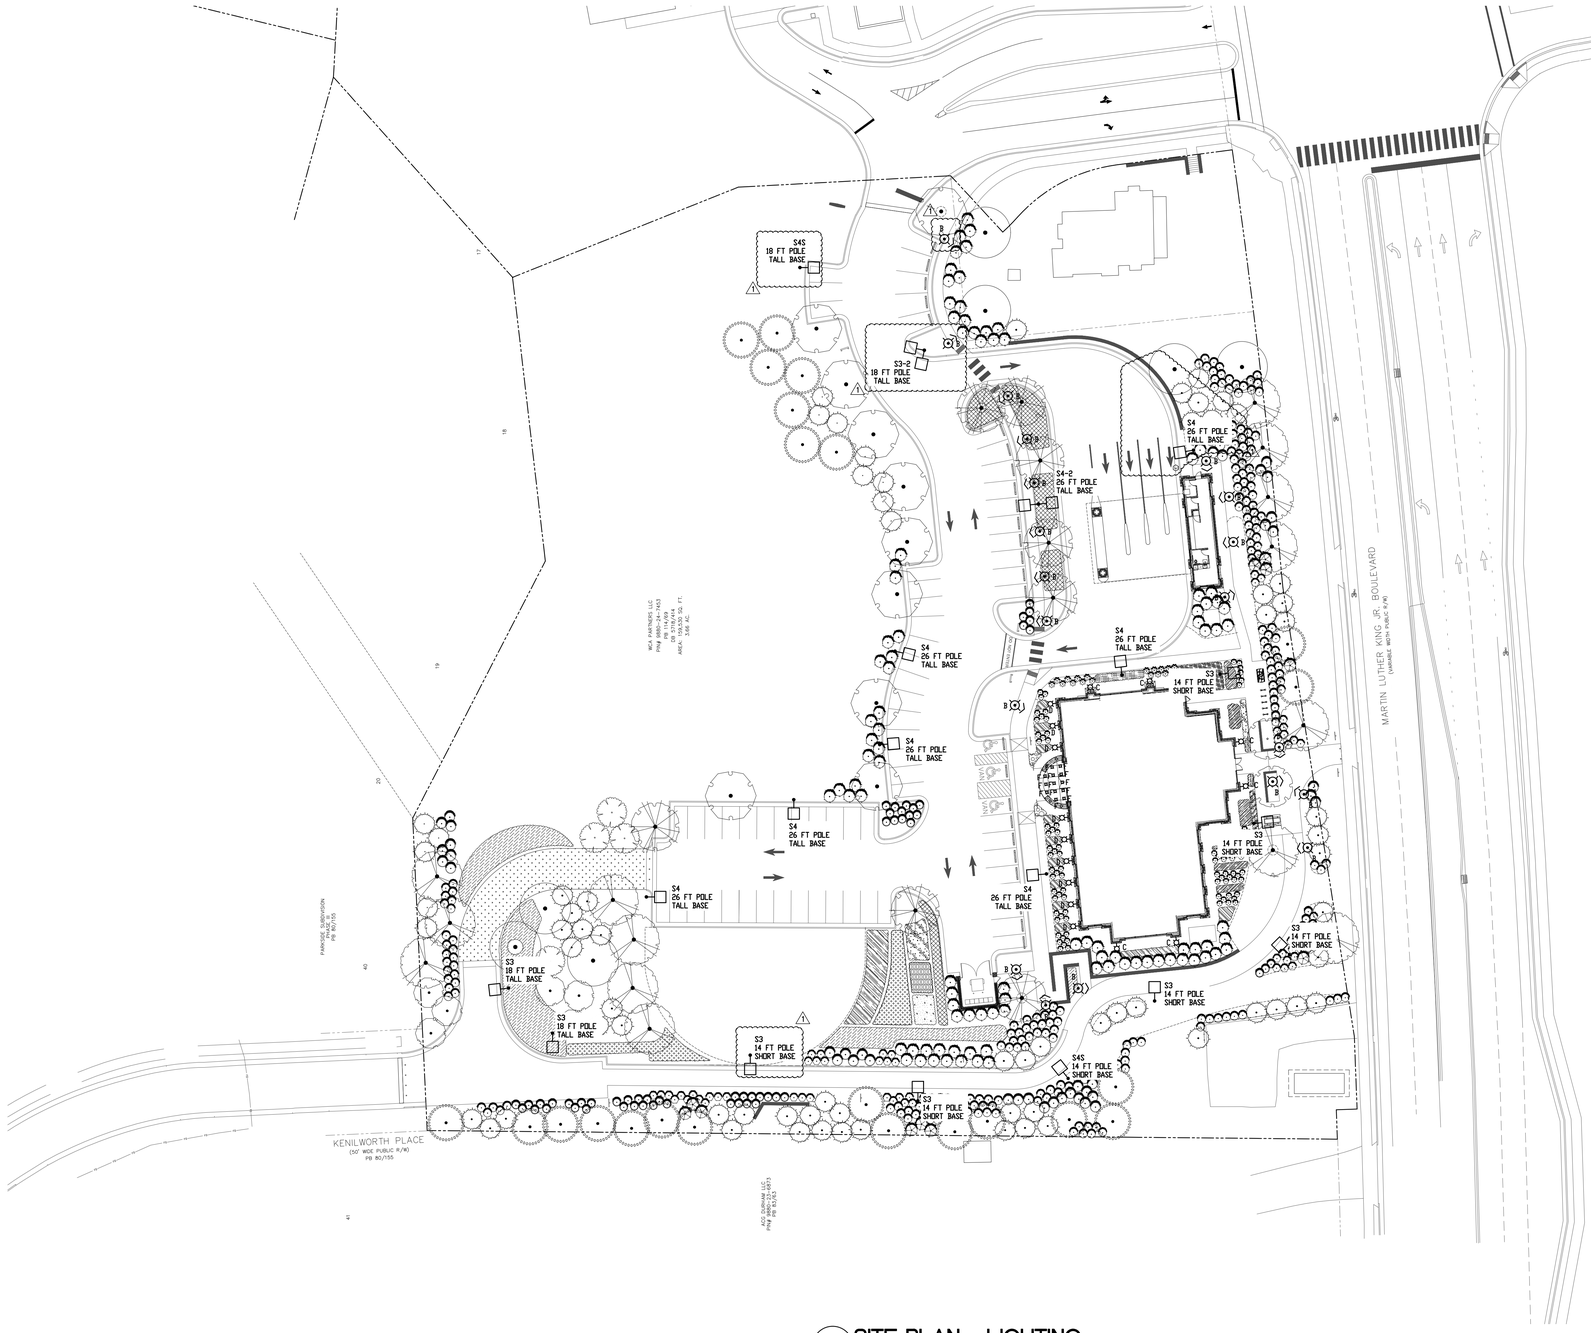

1 SITE PLAN - LIGHTING
SCALE: 1" = 30'

NOTES

1. VERIFY AND COORDINATE ALL LIGHT FIXTURE LOCATIONS WITH SITE, ARCHITECTURAL, HARDSCAPE / LANDSCAPING, ETC. PRIOR TO BEGINNING WORK.
2. COORDINATE ALL CONDUIT ROUTINGS, POLE BASES AND OTHER UNDERGROUND INSTALLATIONS WITH UNDERGROUND UTILITIES AND OTHER UNDERGROUND COMPONENTS PRIOR TO BEGINNING WORK.
3. CONTRACTOR SHALL ENSURE THAT THE POLES MEET ALL NORTH CAROLINA & LOCAL AHJ CODES WITH REGARDS TO EPA RATINGS, BURIAL DEPTHS, POLE REQUIREMENTS, ETC. PRIOR TO BEGINNING WORK.
4. ALL EXTERIOR SITE LIGHTING SHALL BE DESIGNED TO PREVENT OFF-SITE GLARE.

PHOTOMETRIC SITE LEGEND

- POLE FIXTURE - SEE FIXTURE SCHEDULE
- POLE OR BOLLARD FIXTURE - SEE FIXTURE SCHEDULE. IF PRESENT, ARROW INDICATES AIMING DIRECTION.
- BLDG. FIXTURE - SEE FIXTURE SCHEDULE

THESE DRAWINGS WILL BE AT THE SCALE INDICATED WHEN PLOTTED AT 24" X 36"

GRENSHAW CONSULTING
www.grenshawconsulting.com
2516 Sum Street, Suite 200
Durham, NC 27705
919-471-5070 Fax 471-5820
NC LICENSE #C-1166

CAROLINA ENGINEERING CONSULTANTS, P.A.
SEAL 36378
PROFESSIONAL ENGINEER
12/7/18

STATE EMPLOYEES' CREDIT UNION
CHARTERWOOD BRANCH (CHARTERWOOD PH 2)
CHAPEL HILL, ORANGE COUNTY, NC

REVISIONS:

NO.	DATE	DESCRIPTION
1	12/07/18	REVIEW COMMENTS

DATE:
AUGUST 3, 2018

CONTENTS
SITE PLAN - LIGHTING

SHEET
SL1001