


Z:\06063000\000001\06063000\DWG\06063000.DWG - 04.17.2023 3:01 PM

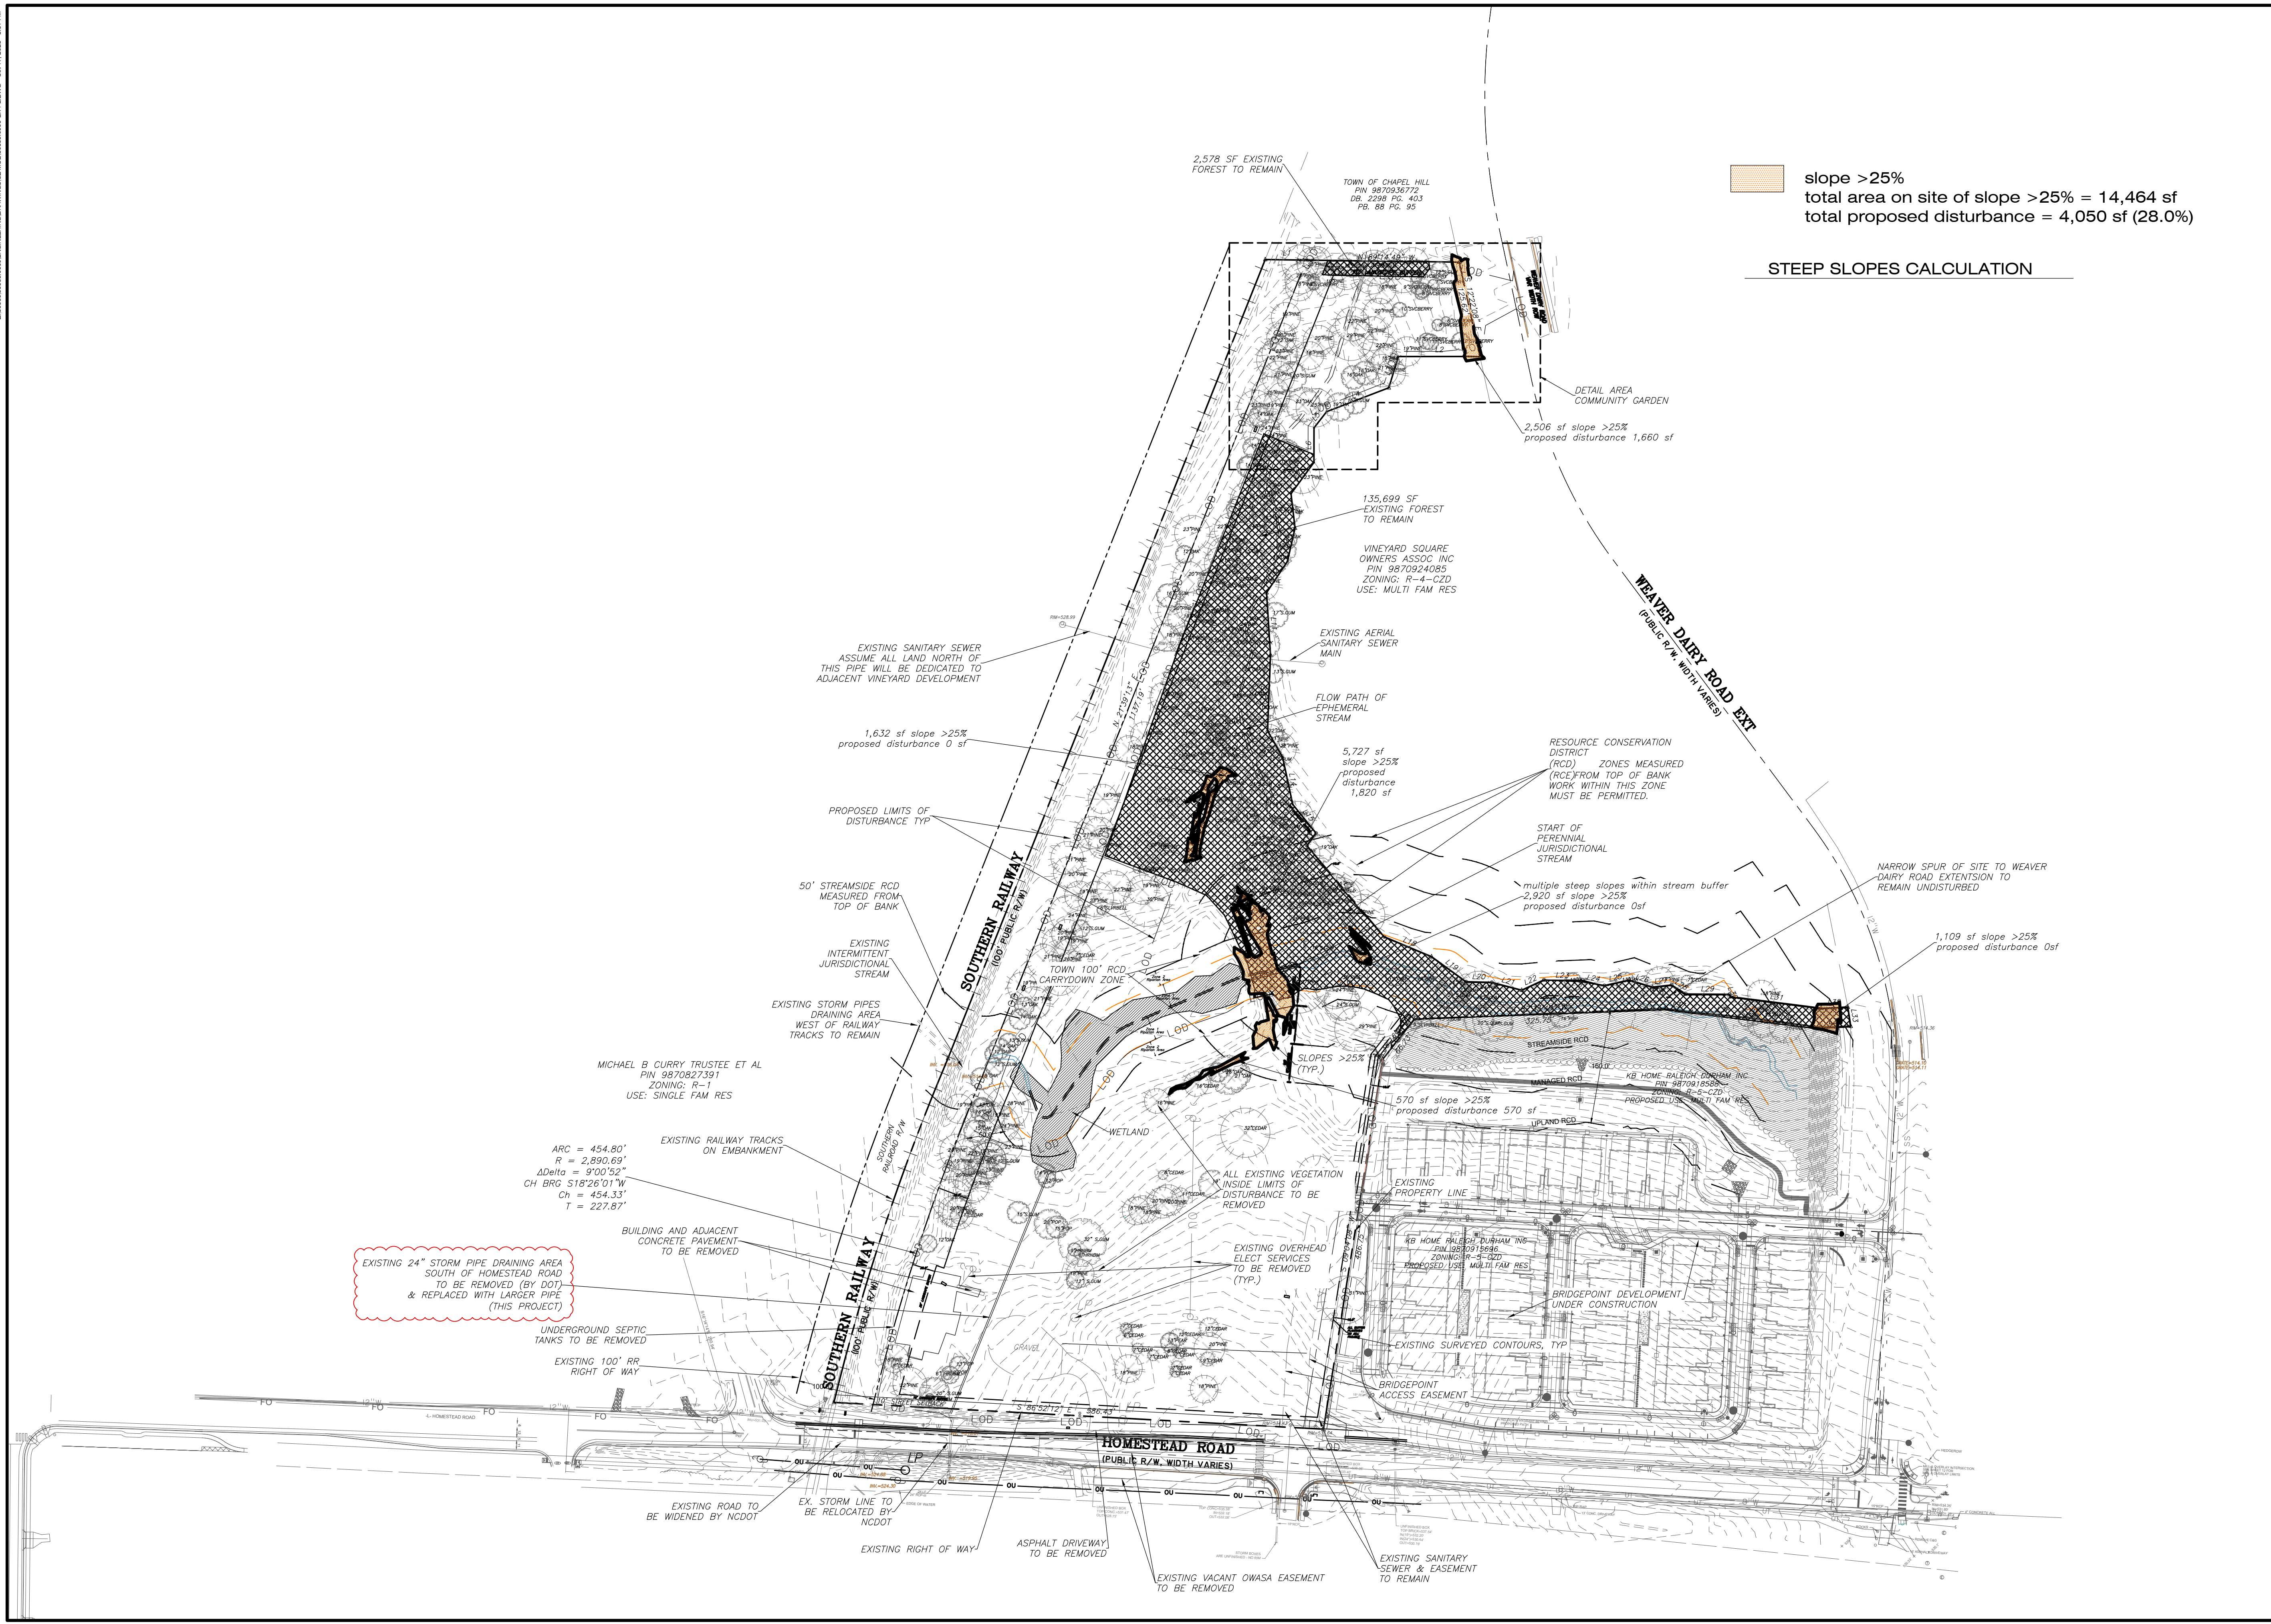

slope >25%
 total area on site of slope >25% = 14,464 sf
 total proposed disturbance = 4,050 sf (28.0%)

STEEP SLOPES CALCULATION

NO.	REVISIONS	BY	DATE
2	SITE LAYOUT REVISION	WLR	10.17.23
1	REVISED PER TRT COMMENTS	WLR	8.11.23



THOMAS & HUTTON

111 West Main Street • Durham, NC 27701 • 919.688.5646


www.thomasandhutton.com

EXISTING CONDITIONS & DEMOLITION PLAN

HOMESTEAD GARDENS

PROJECT LOCATION:
2200 Homestead Road
Chapel Hill, NC

CLIENT:
Self-Help Ventures Fund
301 West Main Street
Durham, NC 27701
Attn: Tucker Bartlett

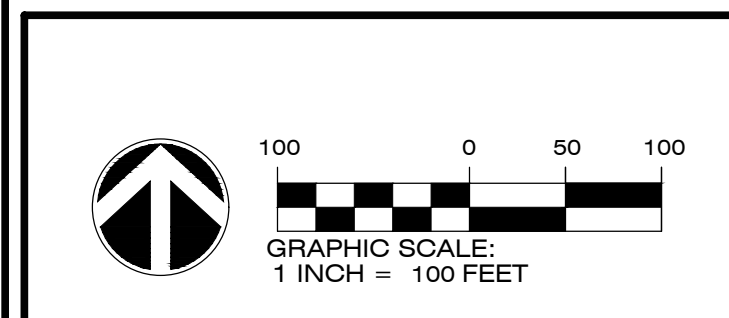


DATUM: HORIZ: NAV83 VERT: NAVD88


JOB NO.: 30969.0000
DATE: 06.21.2023
DRAWN: WLR,MPM,MTG
DESIGNED: WLR,MPM
REVIEWED: WLR,PBR
APPROVED:

D1.1

SCALE: 1" = 100'

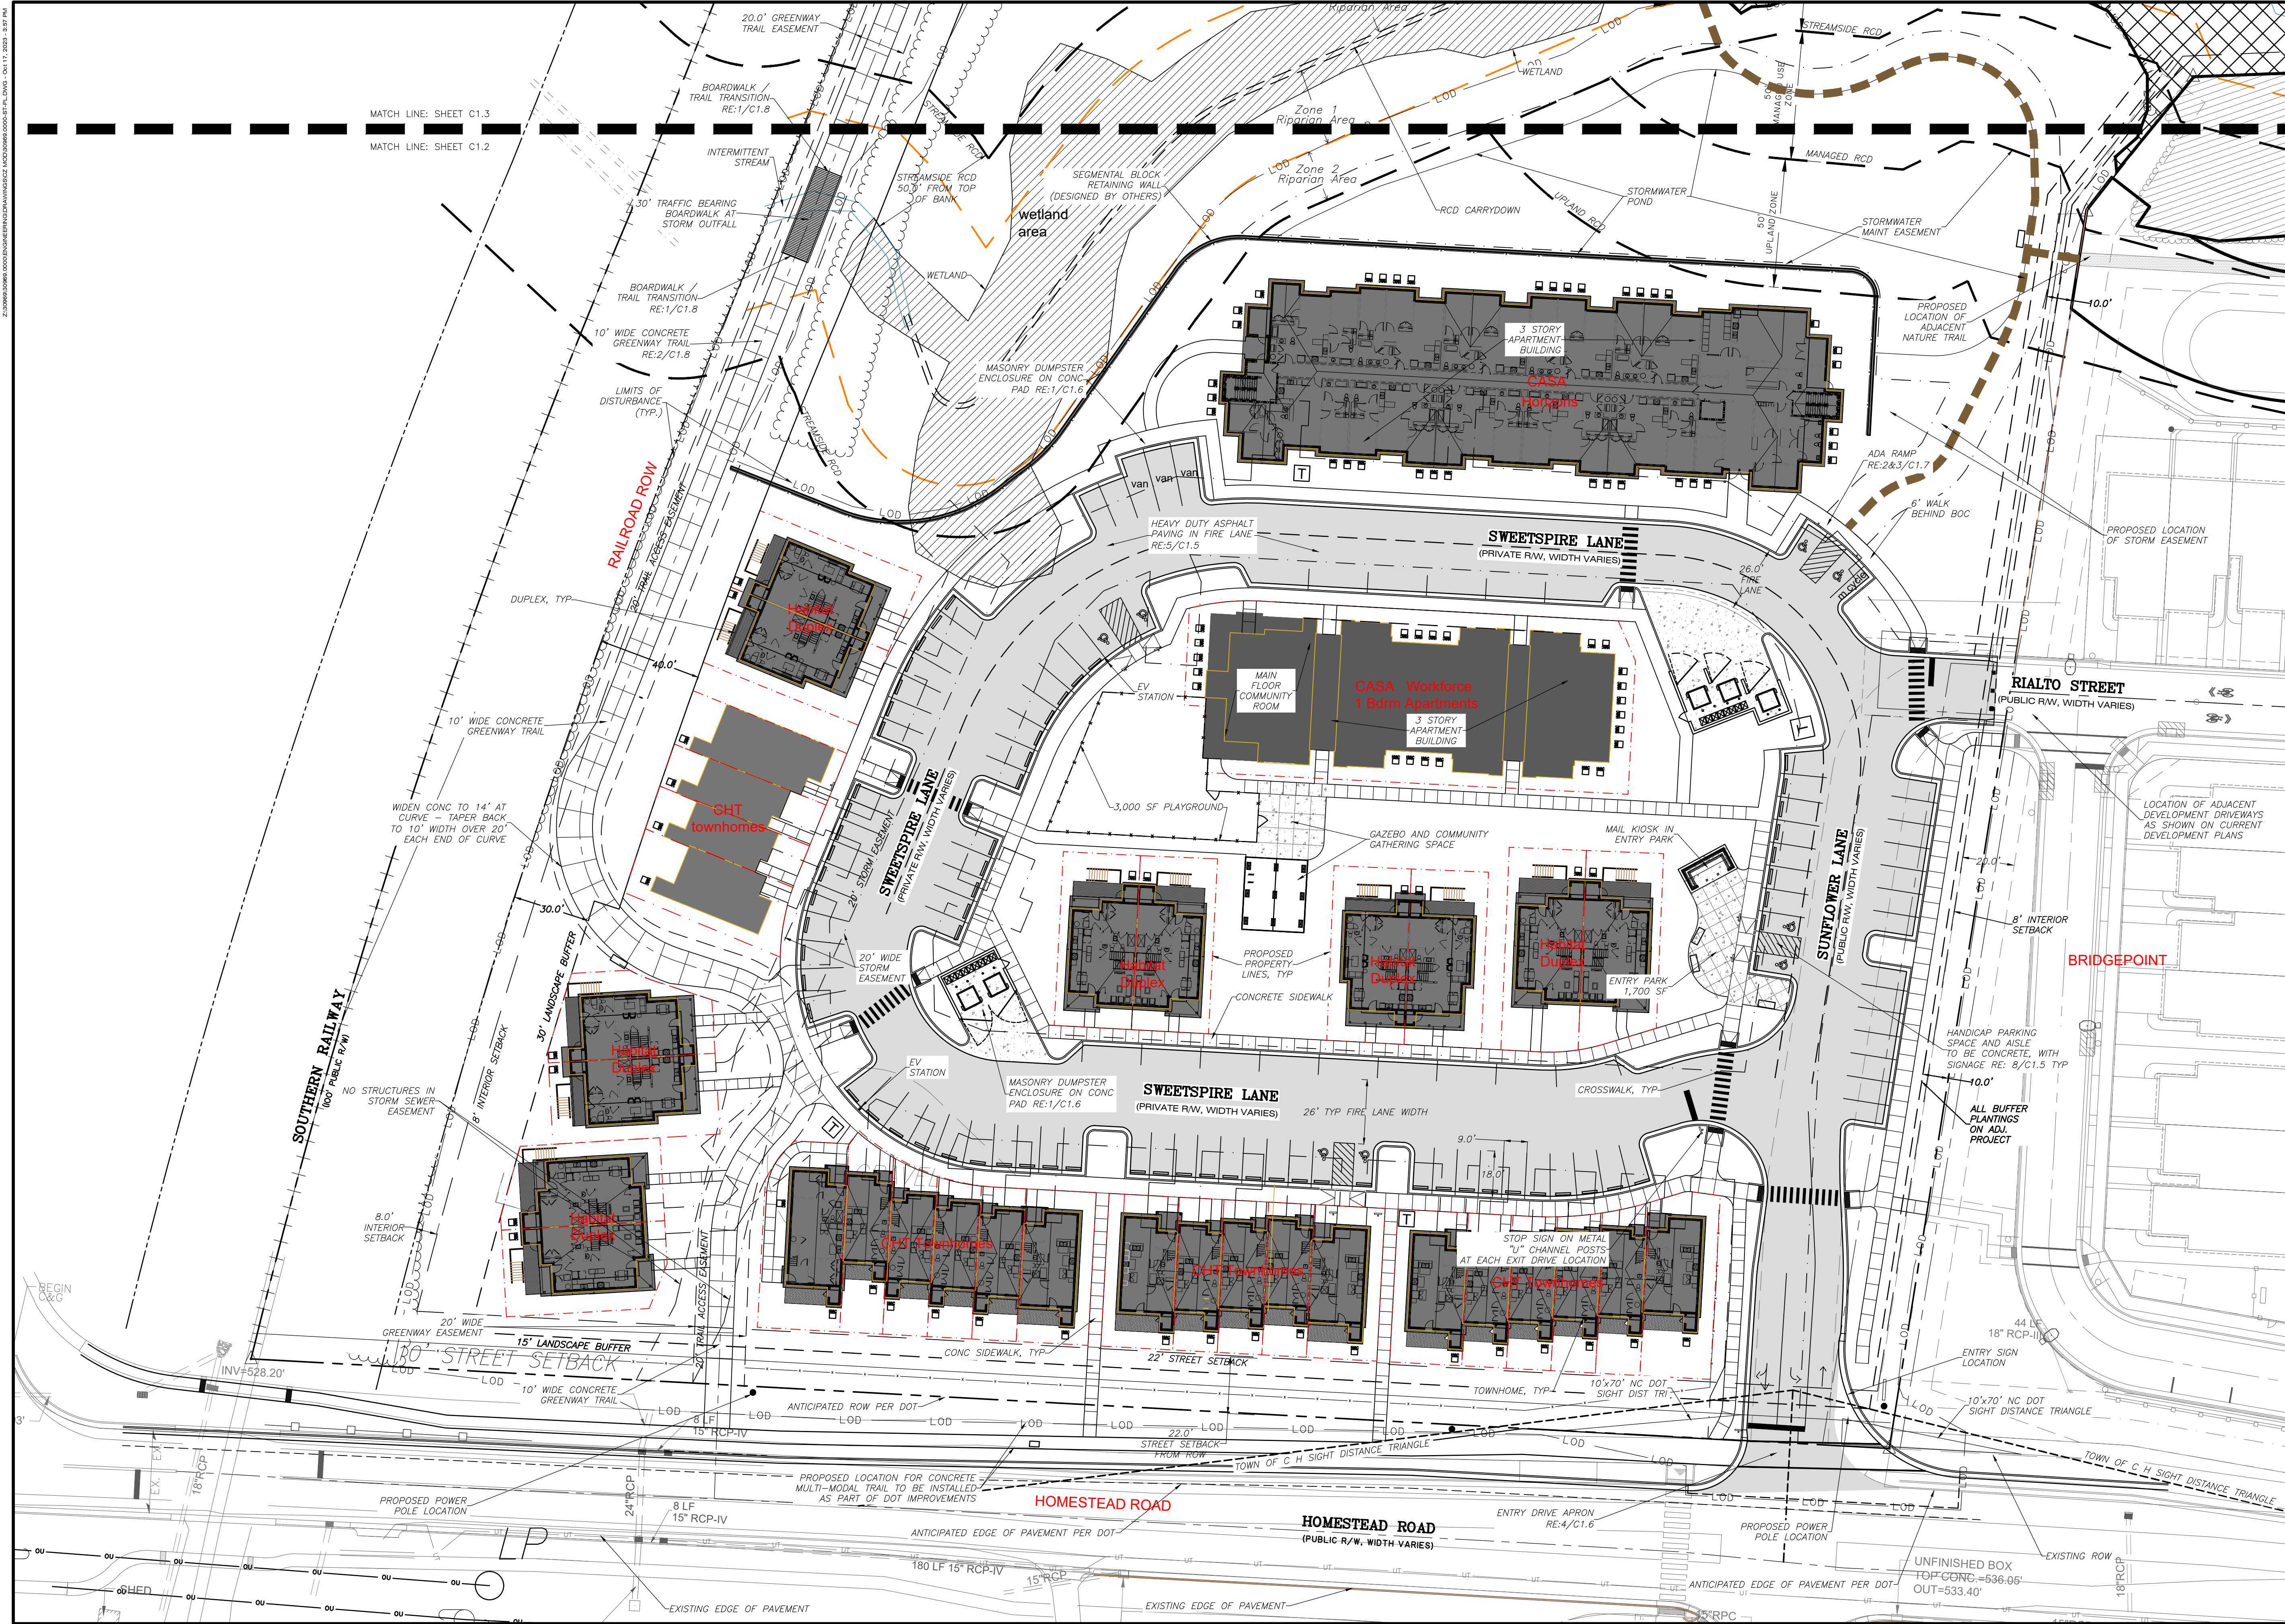

NO.	REVISIONS	BY	DATE
2	TRAIL REVISION - PARK MAINTENANCE ACCESSSITE	WLR	8.29.23
1	LAYOUT REVISION - MOVED DUMPSTER AREA, STREAM LABELS, SIGN, SDTS	WLR	8.11.23

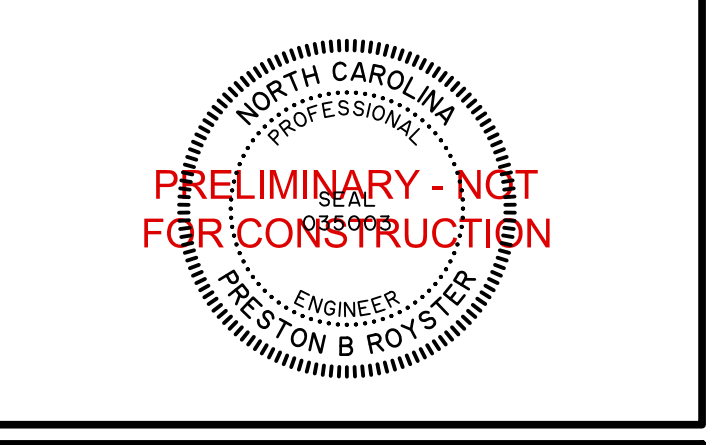

THOMAS & HUTTON
 111 West Main Street • Durham, NC 27701 • 919.688.5646
 www.thomasandhutton.com

SITE PLAN - SOUTH

HOMESTEAD GARDENS

PROJECT LOCATION:
 2200 Homestead Road
 Chapel Hill, NC

CLIENT:
 Self-Help Ventures Fund
 301 West Main Street
 Durham, NC 27701
 Attn: Tucker Bartlett

DATUM: HORIZ: NAV83 VERT: NAVD88

JOB NO: 30969.0000 DATE: 06.21.2023
 DRAWN: WLR,MPM,MTG DESIGNED: WLR,MPM REVIEWED: WLR,PBR APPROVED: [Signature]
 SCALE: 1" = 30'

C1.2

CONTRACTOR SHALL SUBMIT DRAWINGS PREPARED, SIGNED, AND SEALED BY A QUALIFIED LICENSED NORTH CAROLINA PROFESSIONAL ENGINEER FOR REVIEW AND APPROVAL BY THE ARCHITECT, OWNER, AND ENGINEER. CONTRACTOR SHALL BE RESPONSIBLE FOR SUBMITTING FOR AND OBTAINING ANY PERMITS REQUIRED BY THE TOWN OF CHAPEL HILL FOR THE RETAINING WALLS.

1 CONSTRUCTION, SUBMITTAL, AND PERMIT NOTE

- ALL DIMENSIONS AND GRADES SHOWN ON THE PLANS SHALL BE FIELD VERIFIED BY THE CONTRACTOR PRIOR TO CONSTRUCTION. CONTRACTOR SHALL NOTIFY THE OWNER IF ANY DISCREPANCIES EXIST PRIOR TO PROCEEDING WITH CONSTRUCTION FOR NECESSARY PLAN OR GRADE CHANGES. NO EXTRA COMPENSATION SHALL BE PAID TO THE CONTRACTOR FOR ANY WORK DONE DUE TO DIMENSIONS OR GRADES SHOWN INCORRECTLY ON THESE PLANS IF SUCH NOTIFICATION HAS NOT BEEN GIVEN.
- ALL CONSTRUCTION SHALL BE IN ACCORDANCE WITH TOWN OF CHAPEL HILL AND NCDOT STANDARDS AND SPECIFICATIONS.
- CONTRACTOR SHALL NOTIFY "NORTH CAROLINA ONE CALL" (1-800-632-4949) AT LEAST 48 HOURS PRIOR TO BEGINNING CONSTRUCTION OR EXCAVATION TO HAVE EXISTING UTILITIES LOCATED. CONTRACTOR TO CONTACT ANY LOCAL UTILITIES THAT PROVIDE THEIR OWN LOCATOR SERVICES INDEPENDENT OF "NORTH CAROLINA ONE CALL".
- CONSTRUCTION, MAINTENANCE AND REMOVAL OF ALL EROSION CONTROL DEVICES ARE THE RESPONSIBILITY OF THE GENERAL CONTRACTOR.
- EXISTING UTILITIES AND STRUCTURES SHOWN, BOTH UNDERGROUND AND ABOVE GROUND, ARE BASED ON A FIELD SURVEY AND THE BEST AVAILABLE RECORD DRAWINGS. THE CONTRACTOR SHALL VERIFY FIELD CONDITIONS PRIOR TO BEGINNING RELATED CONSTRUCTION. ANY DISCREPANCIES SHALL BE REPORTED TO THE OWNER'S REPRESENTATIVE IMMEDIATELY.
- SOIL UNDER BUILDING PAD, PAVED AREAS AND WITHIN SLOPES GREATER THAN 3:1 (H:V) SHALL BE APPROVED, PLACED AND COMPACTED AS RECOMMENDED BY THE GEOTECHNICAL ENGINEER. THESE SOILS SHALL BE COMPACTED AS SPECIFIED UNLESS OTHERWISE RECOMMENDED BY THE GEOTECHNICAL ENGINEER. ANY UNDERCUT OF SOILS IN THESE AREAS SHALL BE APPROVED BY THE GEOTECHNICAL ENGINEER & OWNER. THE UNDERCUT SOILS SHALL ALSO BE QUANTIFIED BY THE GEOTECHNICAL ENGINEER.
- ALL GRADING MUST PRODUCE SURFACE DRAINAGE ADEQUATE TO PREVENT STANDING WATER OR WET LAWN AREAS, AND TO ENSURE THAT ALL STORM WATER FLOWS TO INLETS OR OTHER POINTS OF DISCHARGE.
- CONNECT ALL ROOF LEADERS AND DOWNSPOUTS TO STORM DRAINAGE SYSTEM WITH PVC PIPE. SEE ARCHITECTURAL PLANS FOR LOCATIONS.
- CURB INLETS: PROVIDE PRE-CAST CURB INLET HOODS AND COVERS STATING, "DUMP NO WASTE! DRAINS TO JORDAN LAKE", IN ACCORDANCE WITH THE SPECIFICATIONS OF THE TOWN STANDARD DETAIL SD-5A, FOR ALL NEW CURB INLETS FOR PRIVATE, TOWN AND STATE RIGHTS-OF-WAY.
- BW (BOTTOM OF WALL) ELEVATION IS FINISH GRADE, NOT THE FOOTING. REFERENCE RETAINING WALL PLANS/DETAILS FOR DEPTH OF FOOTING.
- CONTRACTOR SHALL PROVIDE SHOP DRAWINGS FOR ALL PROPOSED WALLS FOR REVIEW BY ENGINEER, ARCHITECT, AND OWNER. WALL PLANS SHALL BE PREPARED, SIGNED, AND SEALED BY A LICENSED NC PROFESSIONAL ENGINEER. CONTRACTOR AND/OR WALL DESIGNER SHALL BE RESPONSIBLE FOR OBTAINING ALL NECESSARY PERMITS AND APPROVALS FOR WALL CONSTRUCTION. WALLS SHALL BE DESIGNED TO ACCOUNT FOR AND ACCOMMODATE ALL UTILITIES, PIPING, LANDSCAPING, AND ALL APPLIED LOADING.

2 GRADING AND STORM DRAINAGE NOTES

FOR ALL SIDEWALKS/CURB RAMPS THE FOLLOWING APPLIES:


- SIDEWALK SLOPES TO BE A MAXIMUM 4.8%.
- SIDEWALK CROSS SLOPES TO BE A MAXIMUM 1.8%.
- MINIMUM 1' SHOULDER AT MAXIMUM 2% SLOPE ADJACENT TO ADA PAVED ROUTES UNLESS A HANDRAIL IS CALLED OUT.
- ADA PARKING TO BE A MAXIMUM 1.8% SLOPE IN ANY DIRECTION FOR ENTIRE AREA - PARKING SPACES AND AISLES.
- ALL DOORS EXITING THE BUILDING REQUIRE AN ADA ACCESSIBLE COMPLIANT ROUTE TO A PUBLIC WAY.
- PARKING - NUMBER OF SPACES TO COMPLY WITH NCBC 2012 SECTION 1106.1, 1 PER 6 COMPLIANT SPACES OR PORTION THEREOF MUST BE VAN ACCESSIBLE, NO SLOPE TO EXCEED 2% IN ANY DIRECTION. SIGNAGE PER NC REQUIREMENTS, MUTCD AND ICC A 117.1.
- CURB CUTS AND ACCESSIBLE ROUTES PER ICC A117.1 2009 ED. CROSS SLOPE LIMITED TO 2%, CALL FOR INSPECTION BEFORE PLACEMENT OF CONCRETE.
- SLOPES GREATER THAN 5% REQUIRES CONSTRUCTION AS A RAMP.
- CURB RAMPS SHALL HAVE A MAXIMUM RUNNING SLOPE OF 8.33% (12:1).
- CONSTRUCT THE CURB RAMP SIDE FLARE SLOPE AT A MAXIMUM OF 10%, MEASURED ALONG THE CURB LINE.
- CONSTRUCT THE CURB RAMP LANDINGS FOR A SIDEWALK AT A MINIMUM OF 4'x4' WITH A MAXIMUM SLOPE OF 2% IN ANY DIRECTION.
- CONSTRUCT CURB RAMP DETECTABLE WARNING DOMES TO COVER 2'-0" LENGTH AND FULL WIDTH OF THE RAMP FLOOR.

3 SIDEWALK AND CURB RAMP NOTES (APPLIES TO ALL SHEETS)


RCD ZONE	TOTAL AREA ON SITE	PROPOSED DISTURBANCE		PROPOSED IMPERVIOUS	
		SF	%	SF	%
streamside	89,101 SF	14,675 SF	16.5 %	1,300 SF	1.46 %
managed	16,898 SF	9,350 SF	55.3 %	0 SF	0 %
upland	22,345 SF	12,600 SF	56.4 %	175 SF	0.78 %

STREAMSIDE RCD CALCULATIONS INCLUDE THE CARRY DOWN AREA BETWEEN JURISDICTIONAL STREAMS.

4 RESOURCE CONSERVATION DISTRICT CALCULATIONS

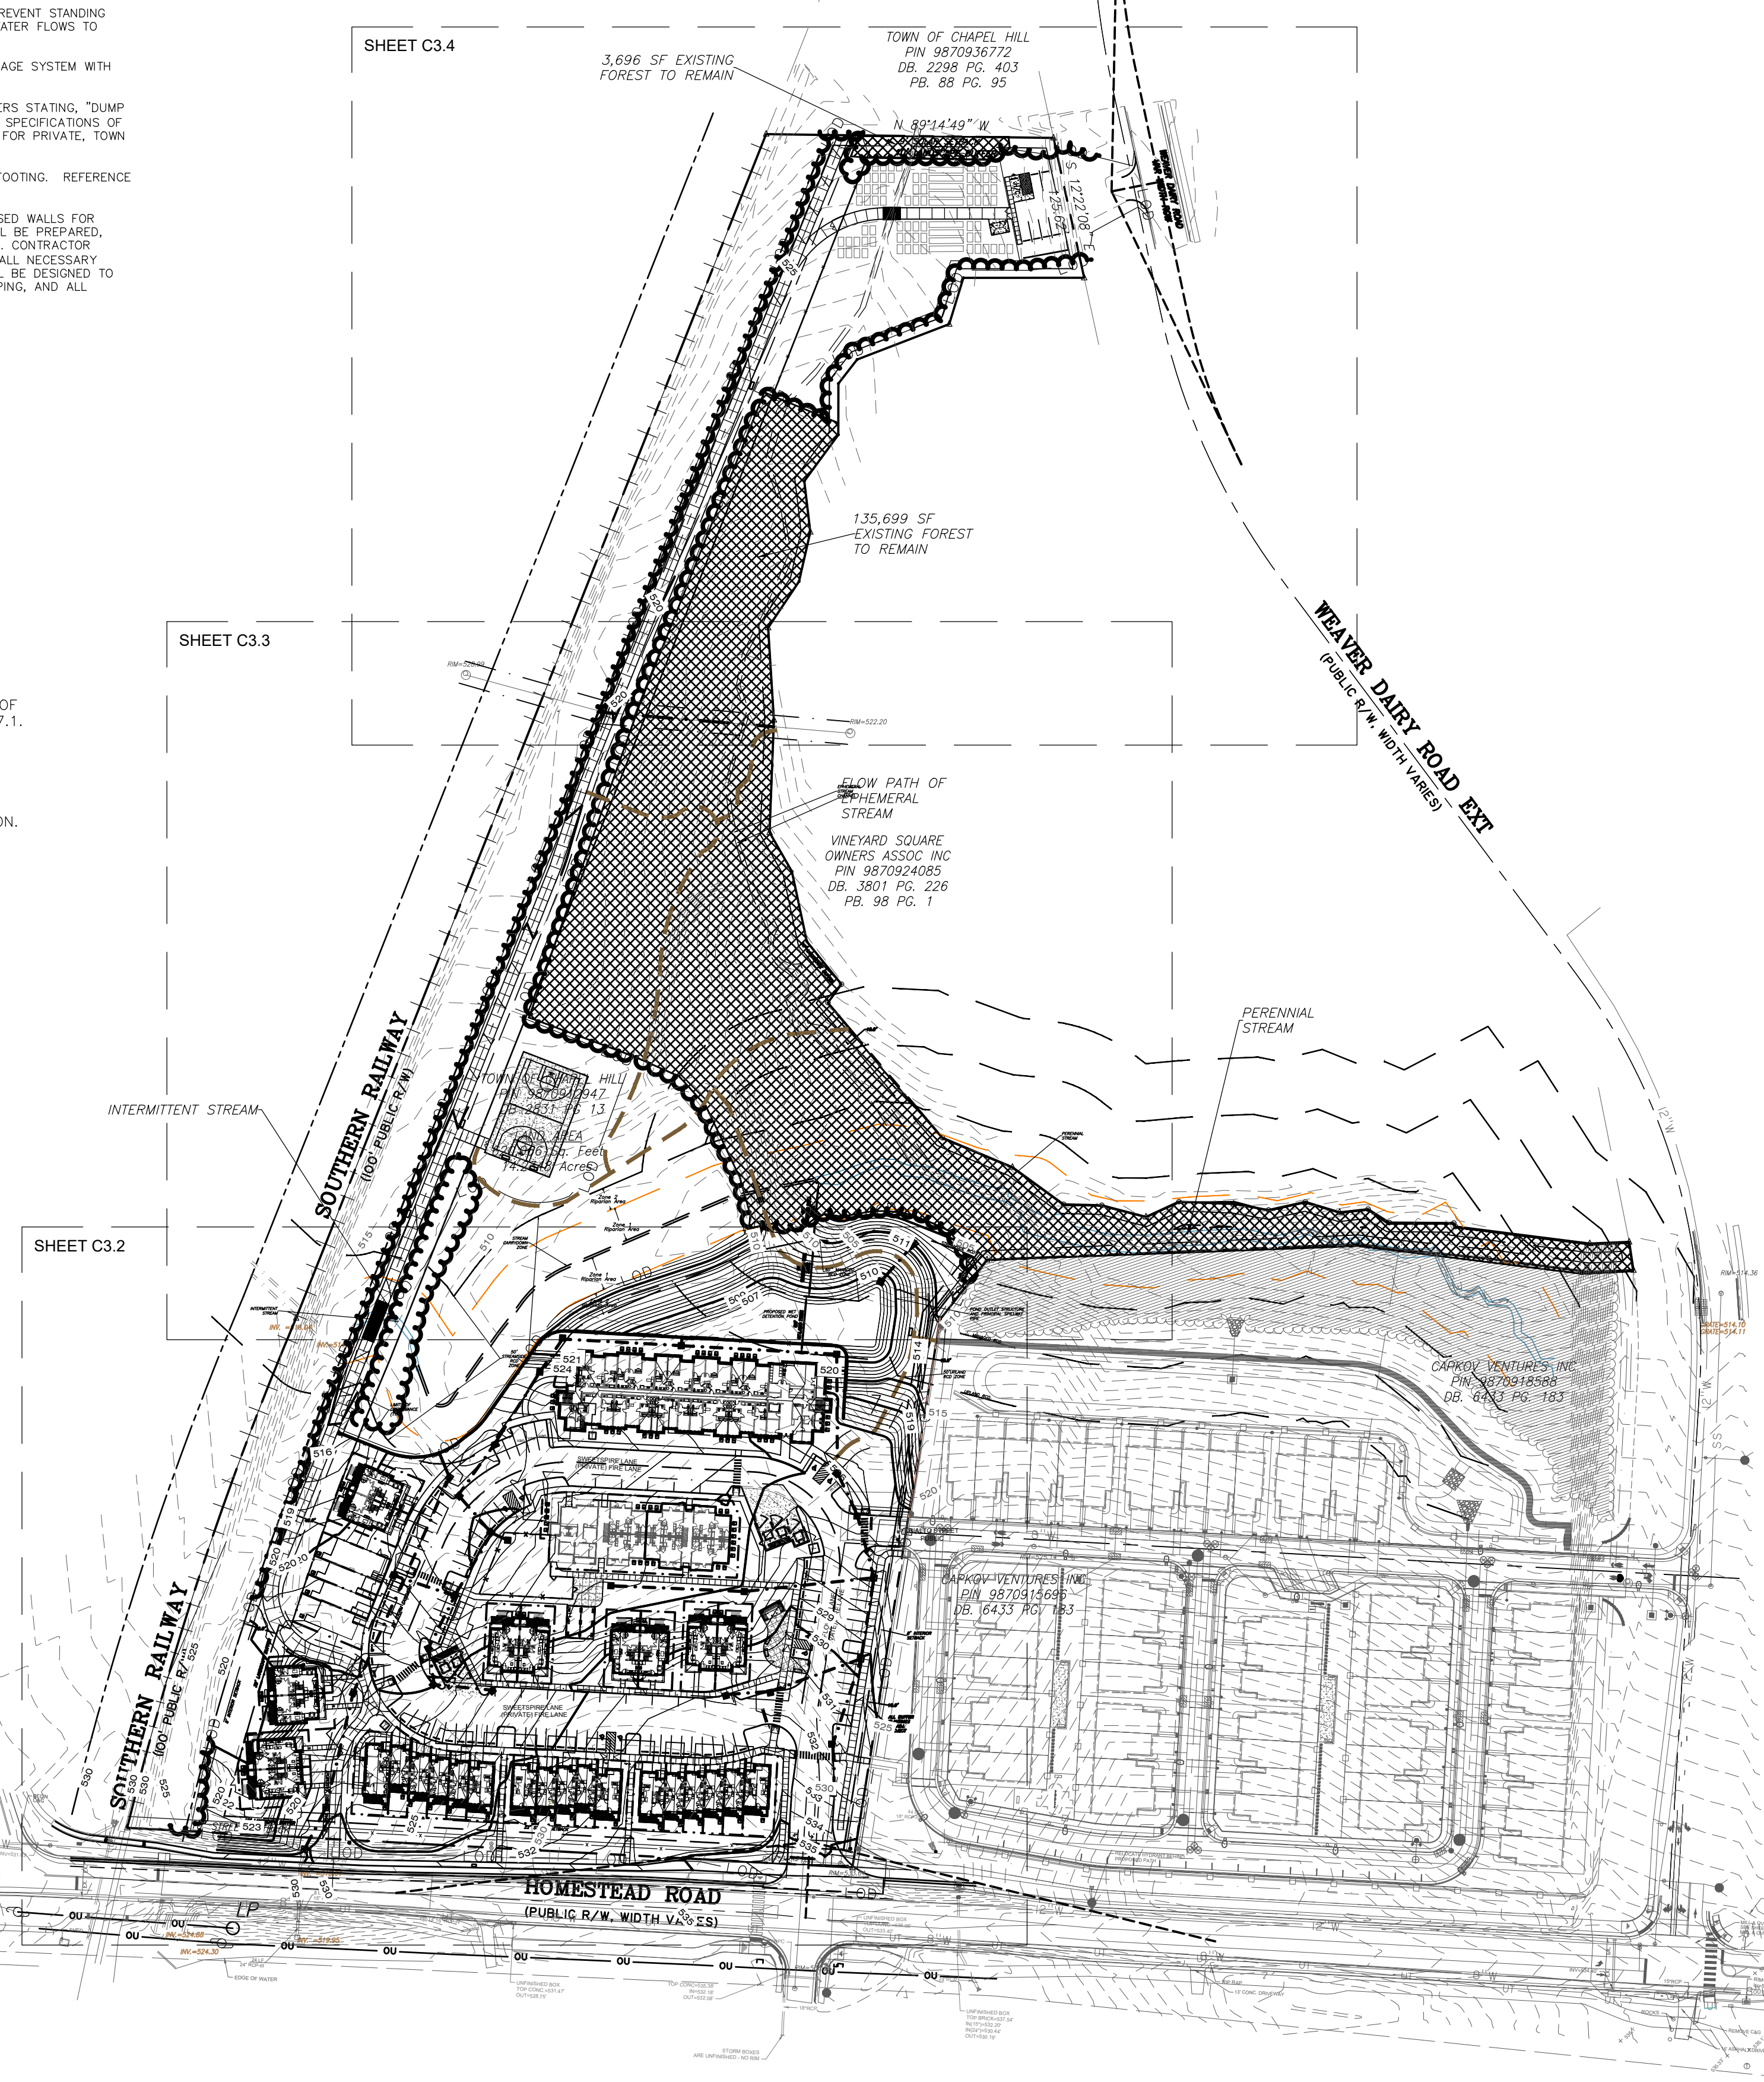

NO.	REVISIONS	BY	DATE
2	SITE LAYOUT REVISION	MPM	10.17.23
1	STREAM LABELS & SHEET NOTES	WLR	8.11.23

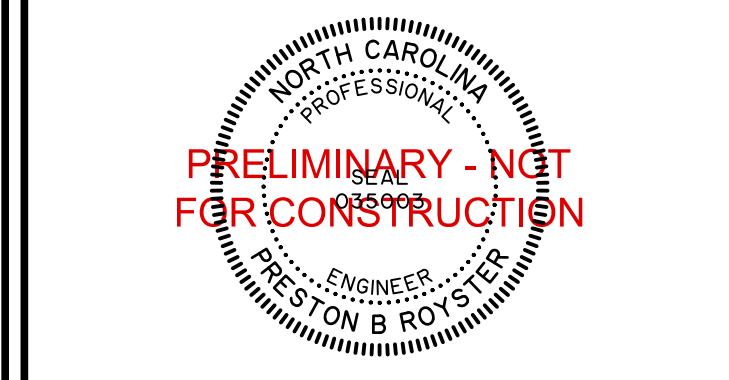


THOMAS & HUTTON
 111 West Main Street • Durham, NC 27701 • 919.688.5646
 www.thomasandhutton.com

GRADING & DRAINAGE PLAN - OVERALL

HOMESTEAD GARDENS

PROJECT LOCATION:
 2200 Homestead Road
 Chapel Hill, NC


CLIENT:
 Self-Help Ventures Fund
 301 West Main Street
 Durham, NC 27701
 Attn: Tucker Bartlett

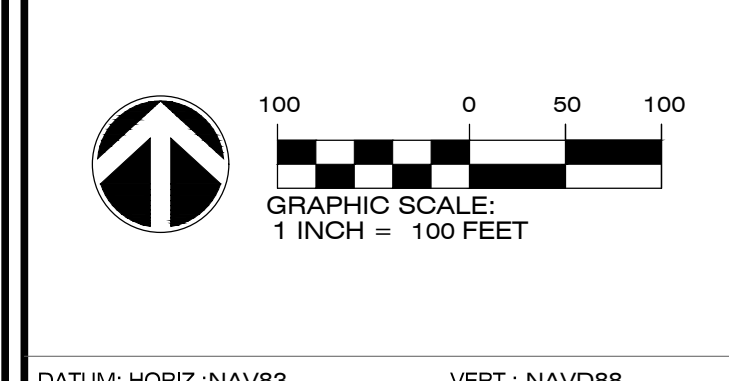

DATUM: HORIZ: NAV83 VERT: NAVD88

JOB NO.: 30969.0000
 DATE: 06.21.2023
 DRAWN: WLR,MPM,MTG
 DESIGNED: WLR,MPM
 REVIEWED: WLR,PBR
 APPROVED: _____
 SCALE: 1" = 100'

C3.1

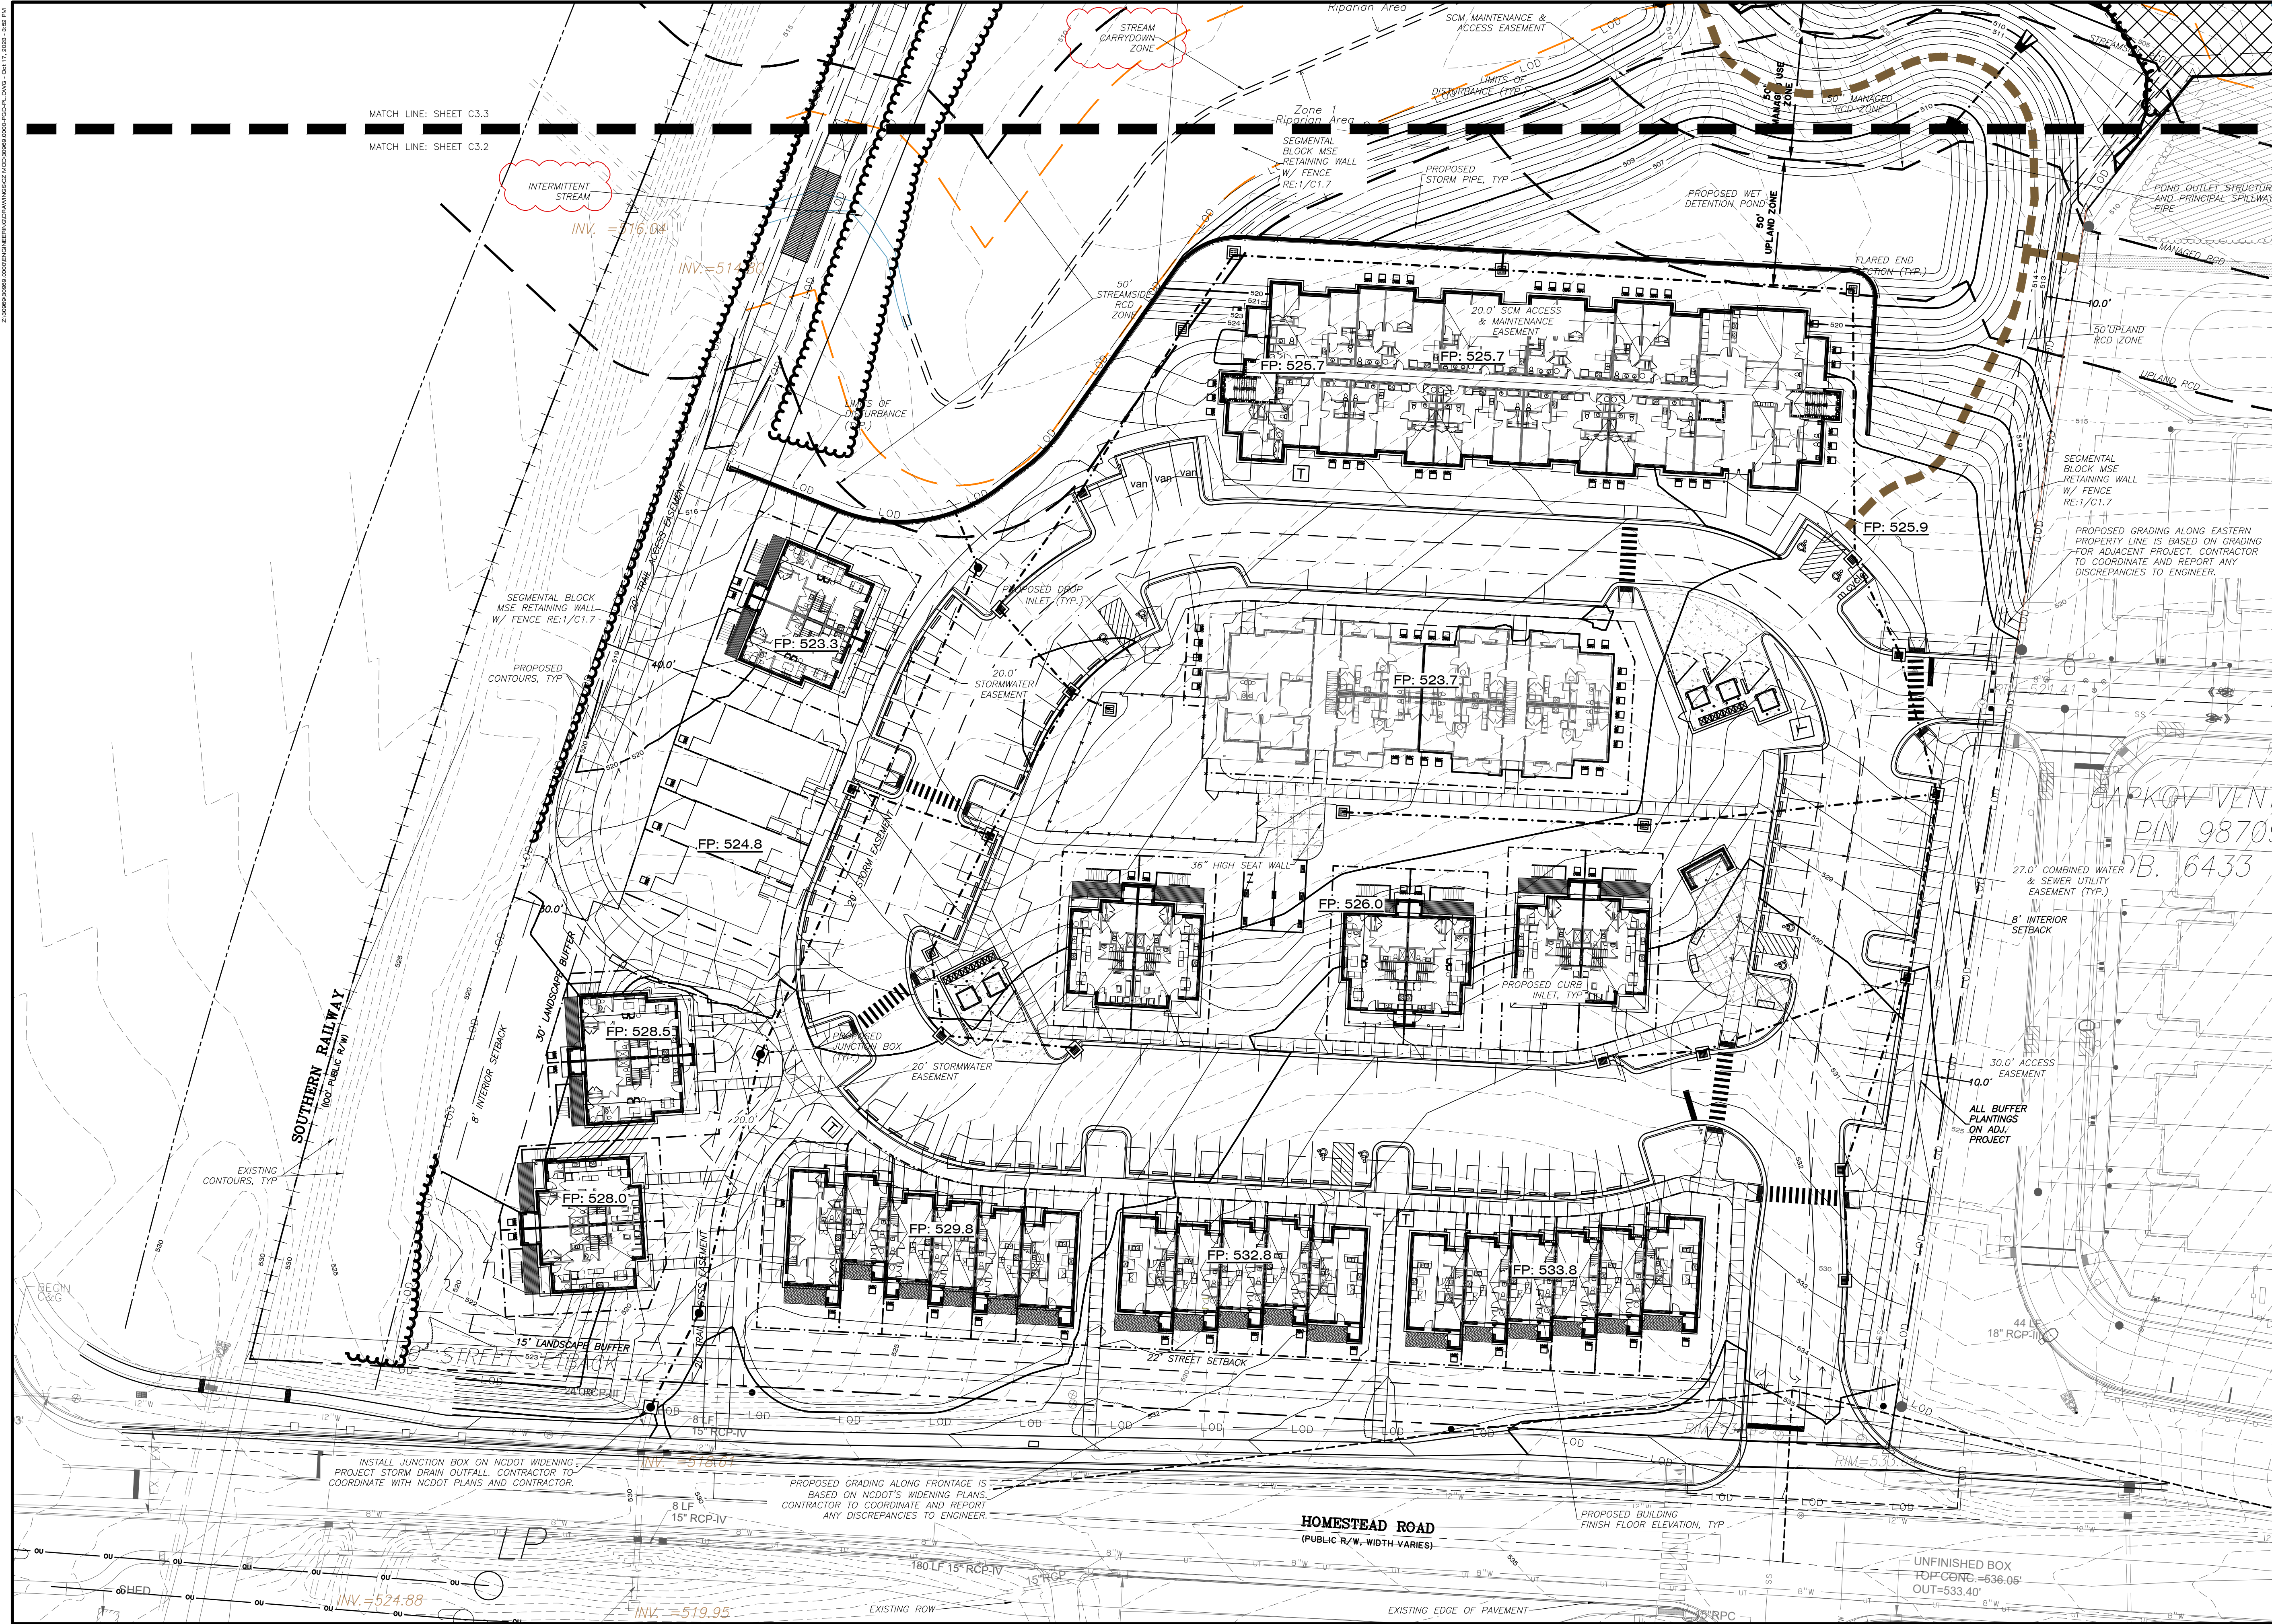

MATCH LINE: SHEET C3.3
 MATCH LINE: SHEET C3.2

NO.	REVISIONS	BY	DATE
2	SITE LAYOUT REVISION	MPM	10.17.23
1	ADDED STREAM LABELS	WLR	8.11.23



THOMAS & HUTTON
 111 West Main Street • Durham, NC 27701 • 919.688.5646
 www.thomasandhutton.com

GRADING & DRAINAGE PLAN - SOUTH

HOMESTEAD GARDENS

PROJECT LOCATION:
 2200 Homestead Road
 Chapel Hill, NC

CLIENT:
 Self-Help Ventures Fund
 301 West Main Street
 Durham, NC 27701
 Attn: Tucker Bartlett

DATUM: HORIZ: NAV83 VERT: NAVD88

JOB NO: 30969.0000
 DATE: 06.21.2023
 DRAWN: WLR,MPM,MTG
 DESIGNED: WLR,MPM
 REVIEWED: WLR,FBR
 APPROVED:
 SCALE: 1" = 30'

C3.2

